FAR CALCULATIONS

Sl. No	Floor	GROSS AREA	OTS	Shafts(service n ventilation)	lift shafts	Net built area	lifts m/c & STAIR HEAD ROOMS	PARKING / TANKS / RAMPS	STAIRCASES / REFUGE AREAS / SERVICES	total far deductions	FAR AREA
1	Level 1: GROUND FLR	8,561.87	501.43			8,060.44		5,265.63	1,033.97	6,299.60	3,445.67
2	Level 2: FIRST FLR	7,537.30	710.40	57.01	23.46	6,746.43		3,959.89	654.54	4,614.43	2,132.00
3	Level 3: SECOND FLR	6,961.13	22.75	57.01	119.22	6,762.15		6,403.20	326.95	6,730.15	32.00
4	Level 4: THIRD FLR	6,961.13	401.99	57.01	119.22	6,382.91		6,023.96	326.95	6,350.91	32.00
5	Level 5: FOURTH FLR	6,961.13	318.04	57.01	119.22	6,466.86		6,107.91	326.95	6,434.86	32.00
6	Level 6: FIFTH FLR	6,961.13	318.04	57.01	119.22	6,466.86		6,107.91	326.95	6,434.86	32.00
7	Level7: SIXTH FLR	6,961.13	528.28	57.01	119.22	6,256.62		5,877.16	347.46	6,224.62	32.00
8	Level 8: SEVENTH FLR	7,114.96	7.15	76.65	119.22	6,911.94			1,128.94	1,128.94	5,783.00
9	Level 9: EIGHTH FLR	7,042.49	7.15	76.65	119.22	6,839.47			1,056.47	1,056.47	5,783.00
10	Level 9: NINTH FLR	7,149.43	7.15	76.65	119.22	6,946.41			1,163.41	1,163.41	5,783.00
11	Level 11: TENTH FLR	7,042.49	7.15	76.65	119.22	6,839.47			1,056.47	1,056.47	5,783.00
12	Level 12: ELEVENTH FLR	7,149.43	7.15	76.65	119.22	6,946.41			1,163.41	1,163.41	5,783.00
13	Level 13: TWELFTH FLR	7,042.49	7.15	76.65	119.22	6,839.47			1,056.47	1,056.47	5,783.00
14	Level 14: THIRTEENTH FLR	7,149.43	7.15	76.65	119.22	6,946.41			1,222.75	1,222.75	5,723.66
15	Level 15: FOURTEENTH FLR	6,983.15	7.15	76.65	119.22	6,780.13			1,056.47	1,056.47	5,723.66
16	Level 16: FIFTEENTH FLR	7,042.49	1047.98	73.77	119.22	5,801.52			655.34	655.34	5,146.18
17	Level 17: SIXTEENTH FLR	5,985.43	1558.14	174.01	23.46	4,229.82			487.46	487.46	3,742.36
18	Level 18: SEVENTEENTH FLR	2,347.79	5.19	116.97	119.22	2,106.41	299.36		403.86	703.22	1,403.19
19	Level 19: EIGHTEENTH FLR	302.78				302.78					302.78
20	Level 20: NINTEENTH FLR	302.78				302.78					302.78
	TOTAL in sqm	**123,559.97**	**5,469.44**	**1,320.01**	**1,835.22**	**114,935.30**	**299.36**	**39,745.66**	**13,794.82**	**53,839.84**	**62,780.29**

PARKING

PARTICULARS	PCU
OFFICE AREAS = 47522 @ 1PCU/50SQM	950
RETAIL/ HOSPITALITY = 5417.30@1PCU/75SQM	72
HOTEL ROOMS =(60+60) @1PCU FOR EVERY 2 ROOM	60
SUB TOTAL	1083
10% FOR VISITORS	108
TOTAL REQUIRED CAR PARKS	**1191**
TOTAL CAR PARKS PROVIDED	**1432**

Statement of areas

Particulars	Area (sqm)
TOTAL SITE AREA 32 ACRES 27 guntas SY NOS. 159/1,159/2,160/1,167/1,167/2,167/3,167/4, 169/1,169/2,169/3,171,173/1 & 173/2	132,235.73
DEVELOPMENT SITE **(SY NO 173/1 &173/2) CARVED OUT OF THE TOTAL SITE DEVELOPEMENT OF 32 ACRES 27 guntas**	19,367.59
FAR	
PERMISSABLE = 3.25	62,944.67
ACHIEVED = 3.24 <3.25	62,780.29
COVERAGE	
PERMISSABLE = 45% OF 19367.59	8,715.42
ACHIEVED = 36.17% < 45%	7,005.87

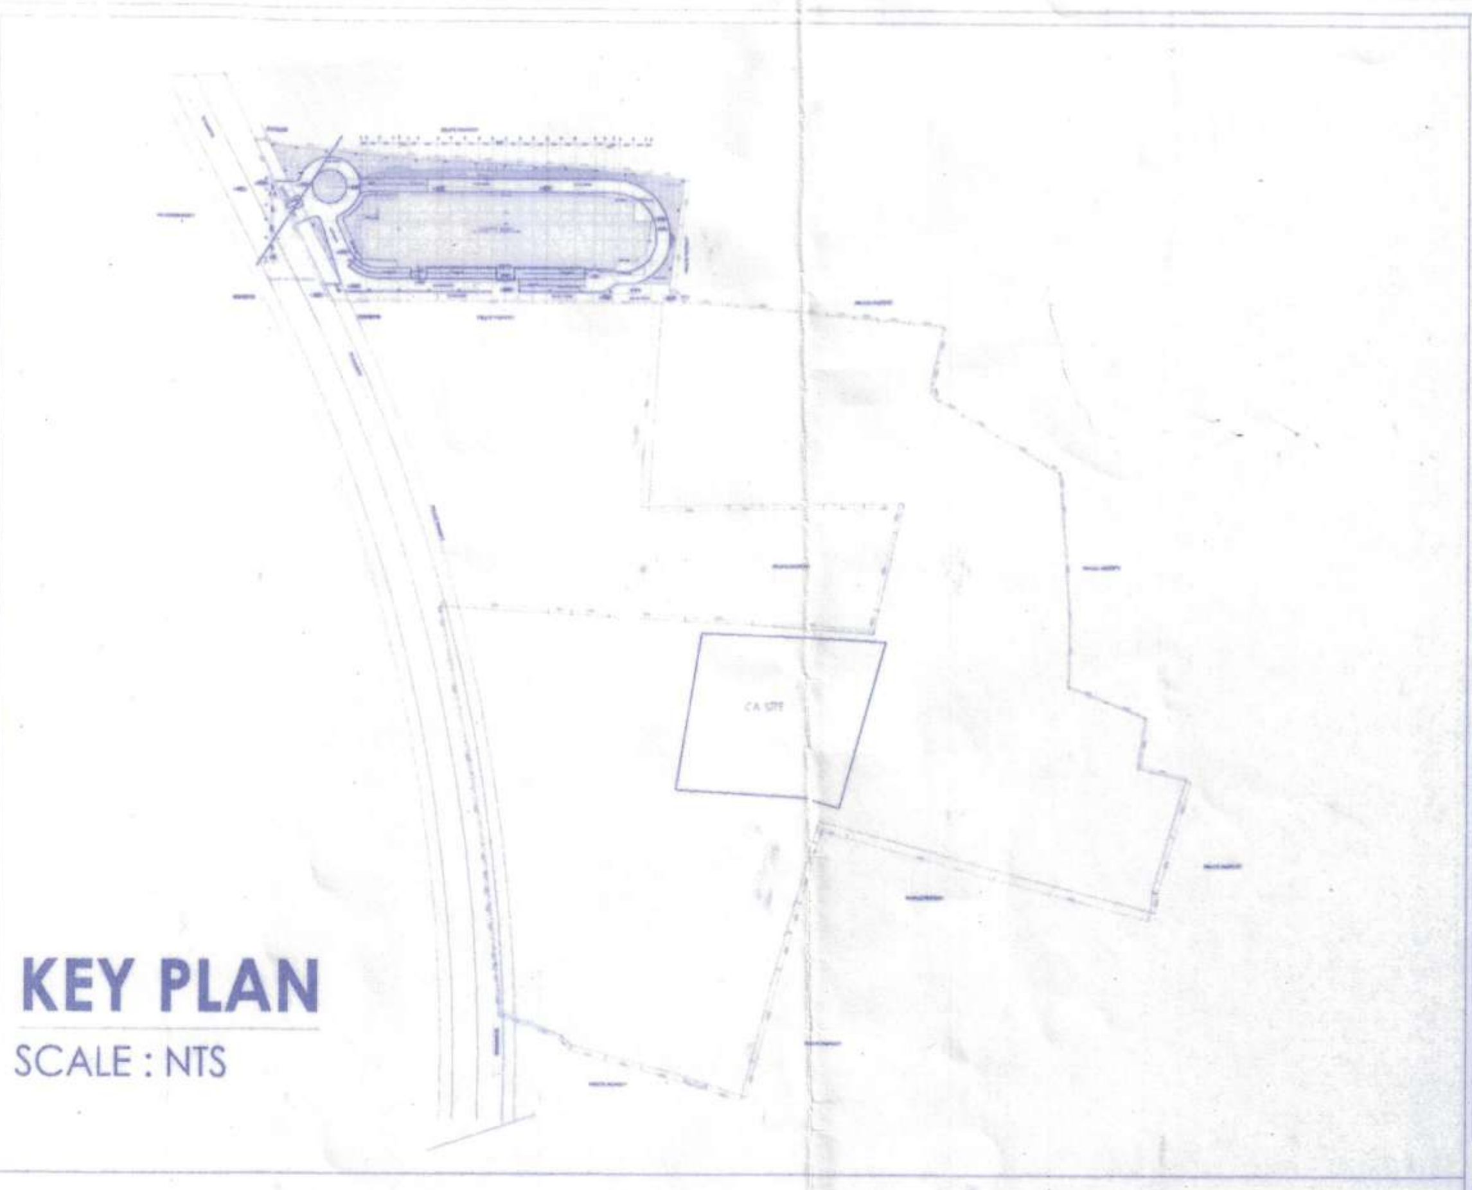

KEY PLAN

SCALE : NTS

LOCATION PLAN

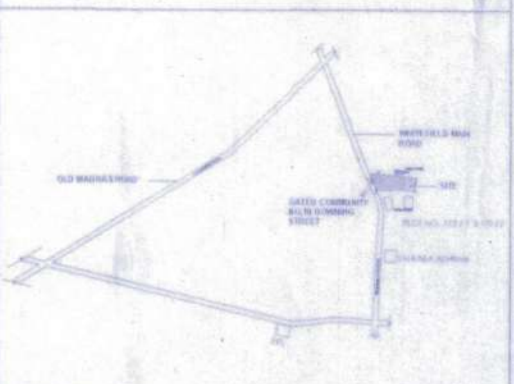

SCALE : NTS

SPECIFIC NOTES

ALL DIMENSIONS ARE IN MILLIMETRES

DETAILS OF RAIN WATER HARVESTING STRUCTURES

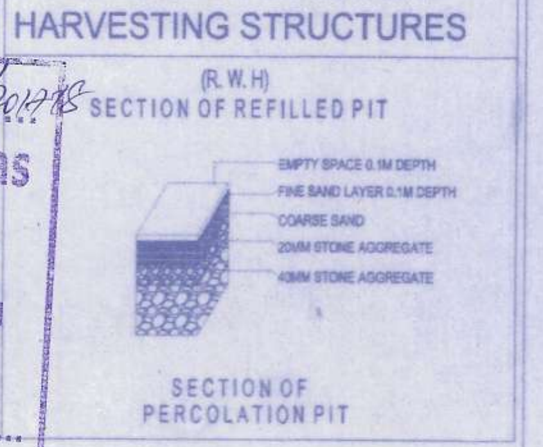

IADB/DO/II/SUC/13767/[illegible]/2017-18
The Karnataka Industrial Areas
DEVELOPMENT BOARD
BANGALORE - 560 001
LICENCE IS GRANTED AS PER PLAN
VALID UPTO: 08-03-2019
Date: 09/03/2018
Development Officer
& Executive Engineer - II

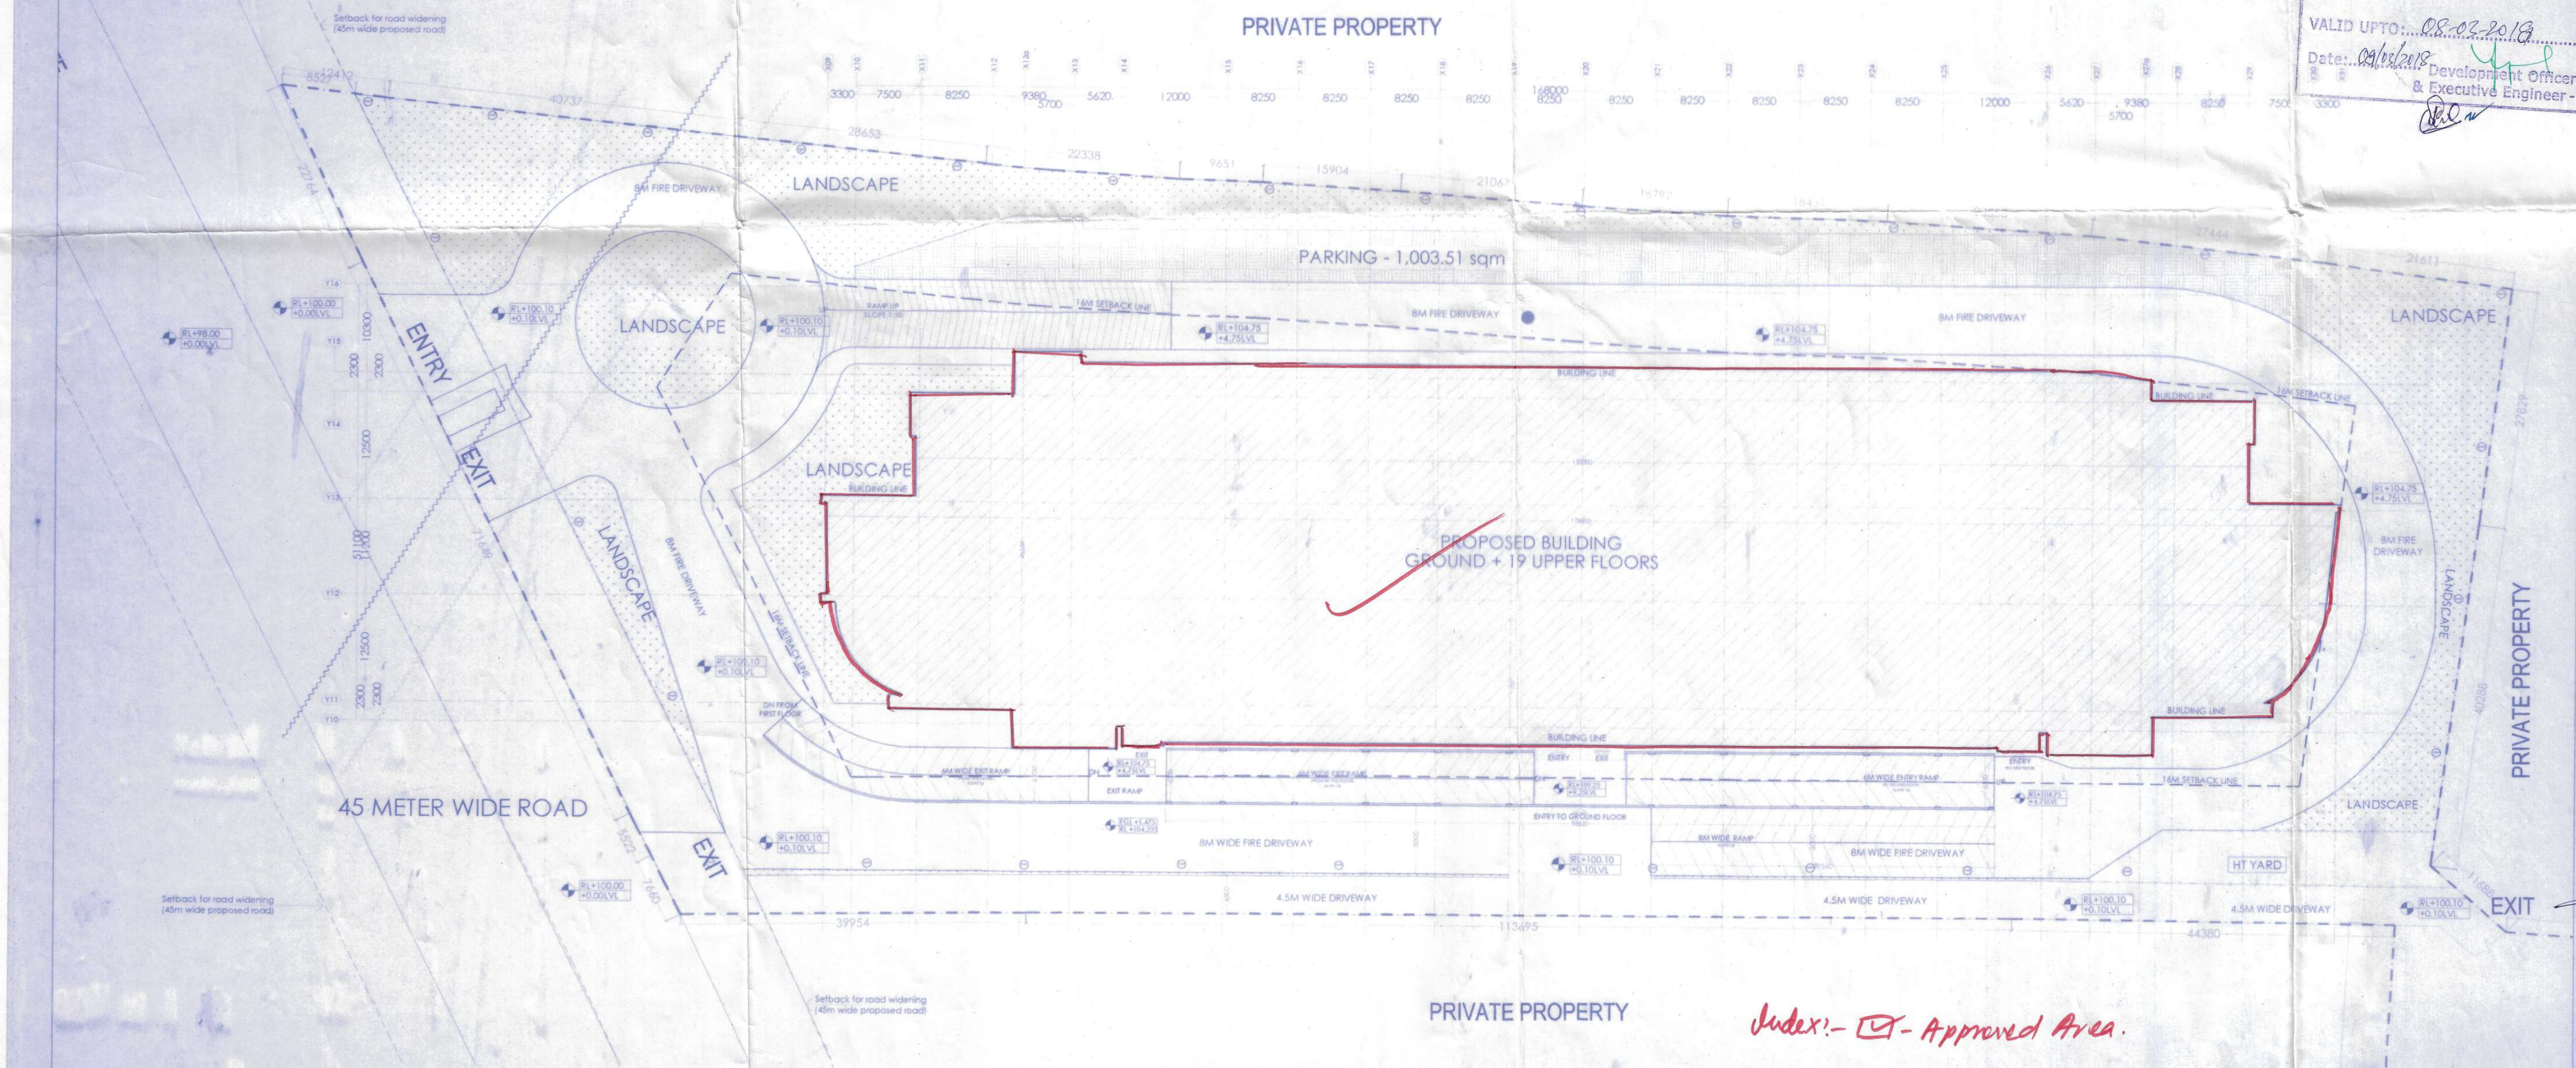

Index:- ☐ - Approved Area.

DEVELOPMENT PLAN - SY Nos 173 /1&173 /2

MRUTHYUNJAYA
EMP No. KIADB/Engr/006/2017-18

PROJECT :
"WHITEFIELD TOWERS"
PROPOSED BUILDING (BONSAI) FOR
M/S AUBERGINE PROPERTIES PVT LTD.
ON SY NO 173/1 & 173/2 OF
KANNAMANGALA VILLAGE ,
BIDHARA HALLI HOBLI,
BANGALORE EAST TALUK,
BANGALORE -560067

OWNER'S SIGNATURE
For Aubergine Properties Pvt. Ltd.
Authorised Signatory

ARCHITECT'S SIGNATURE
Antony Kunnel George
COA Regn. No. CA/98/22820
BCC Regn. No. BCC/BL 3.2.3/A-815/98-99

SUBJECT OF THE DRAWING :
SITE PLAN
LOCATION PLAN
SCHEDULE OF AREAS

SHEET NO :	2 OF 2
SCALE :	1:400
DATE :	18.02.2011

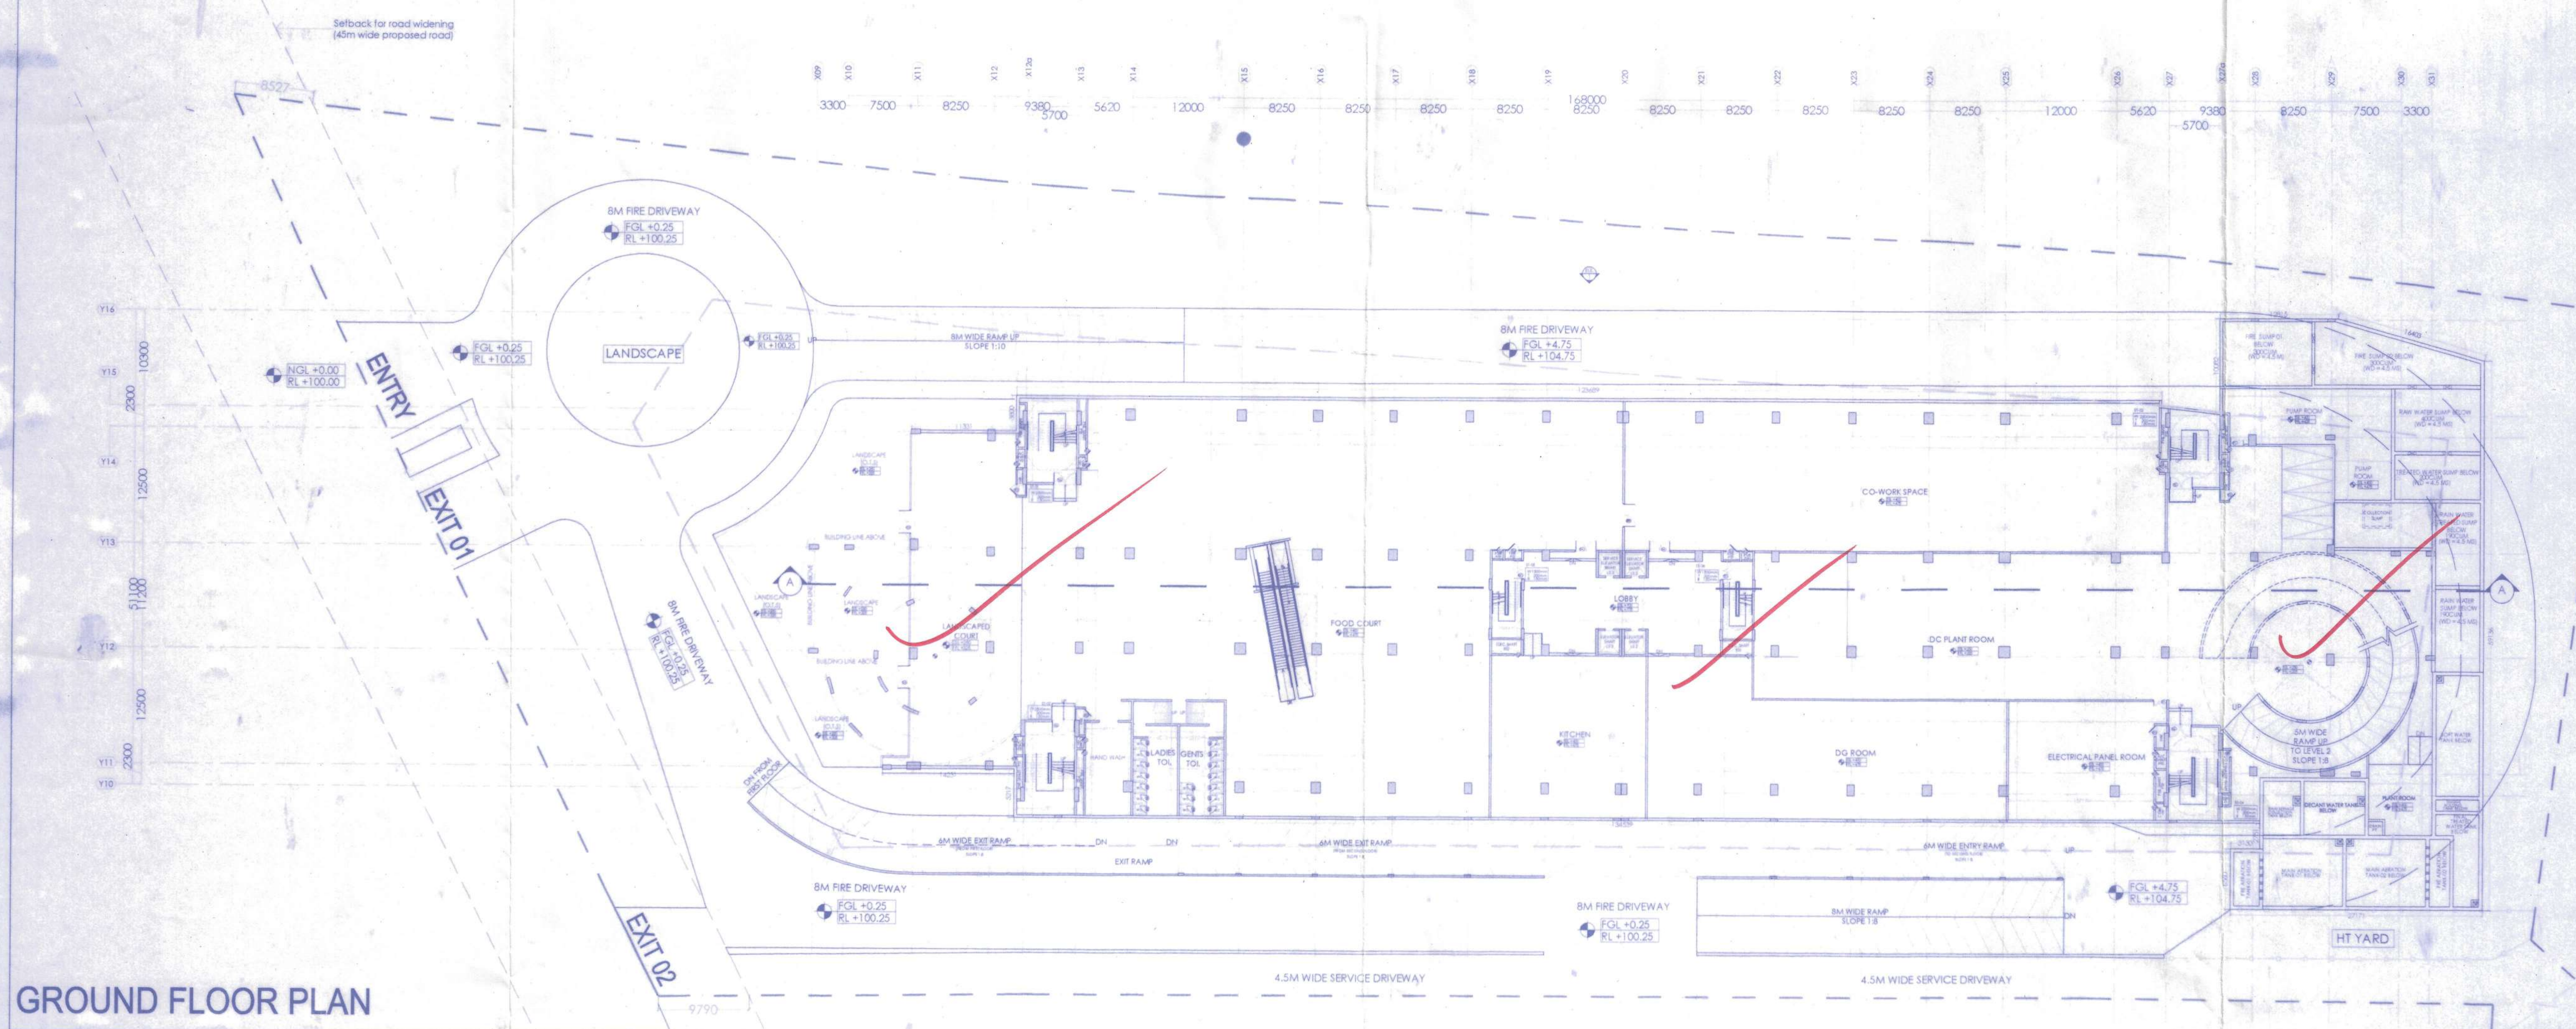

GROUND FLOOR PLAN

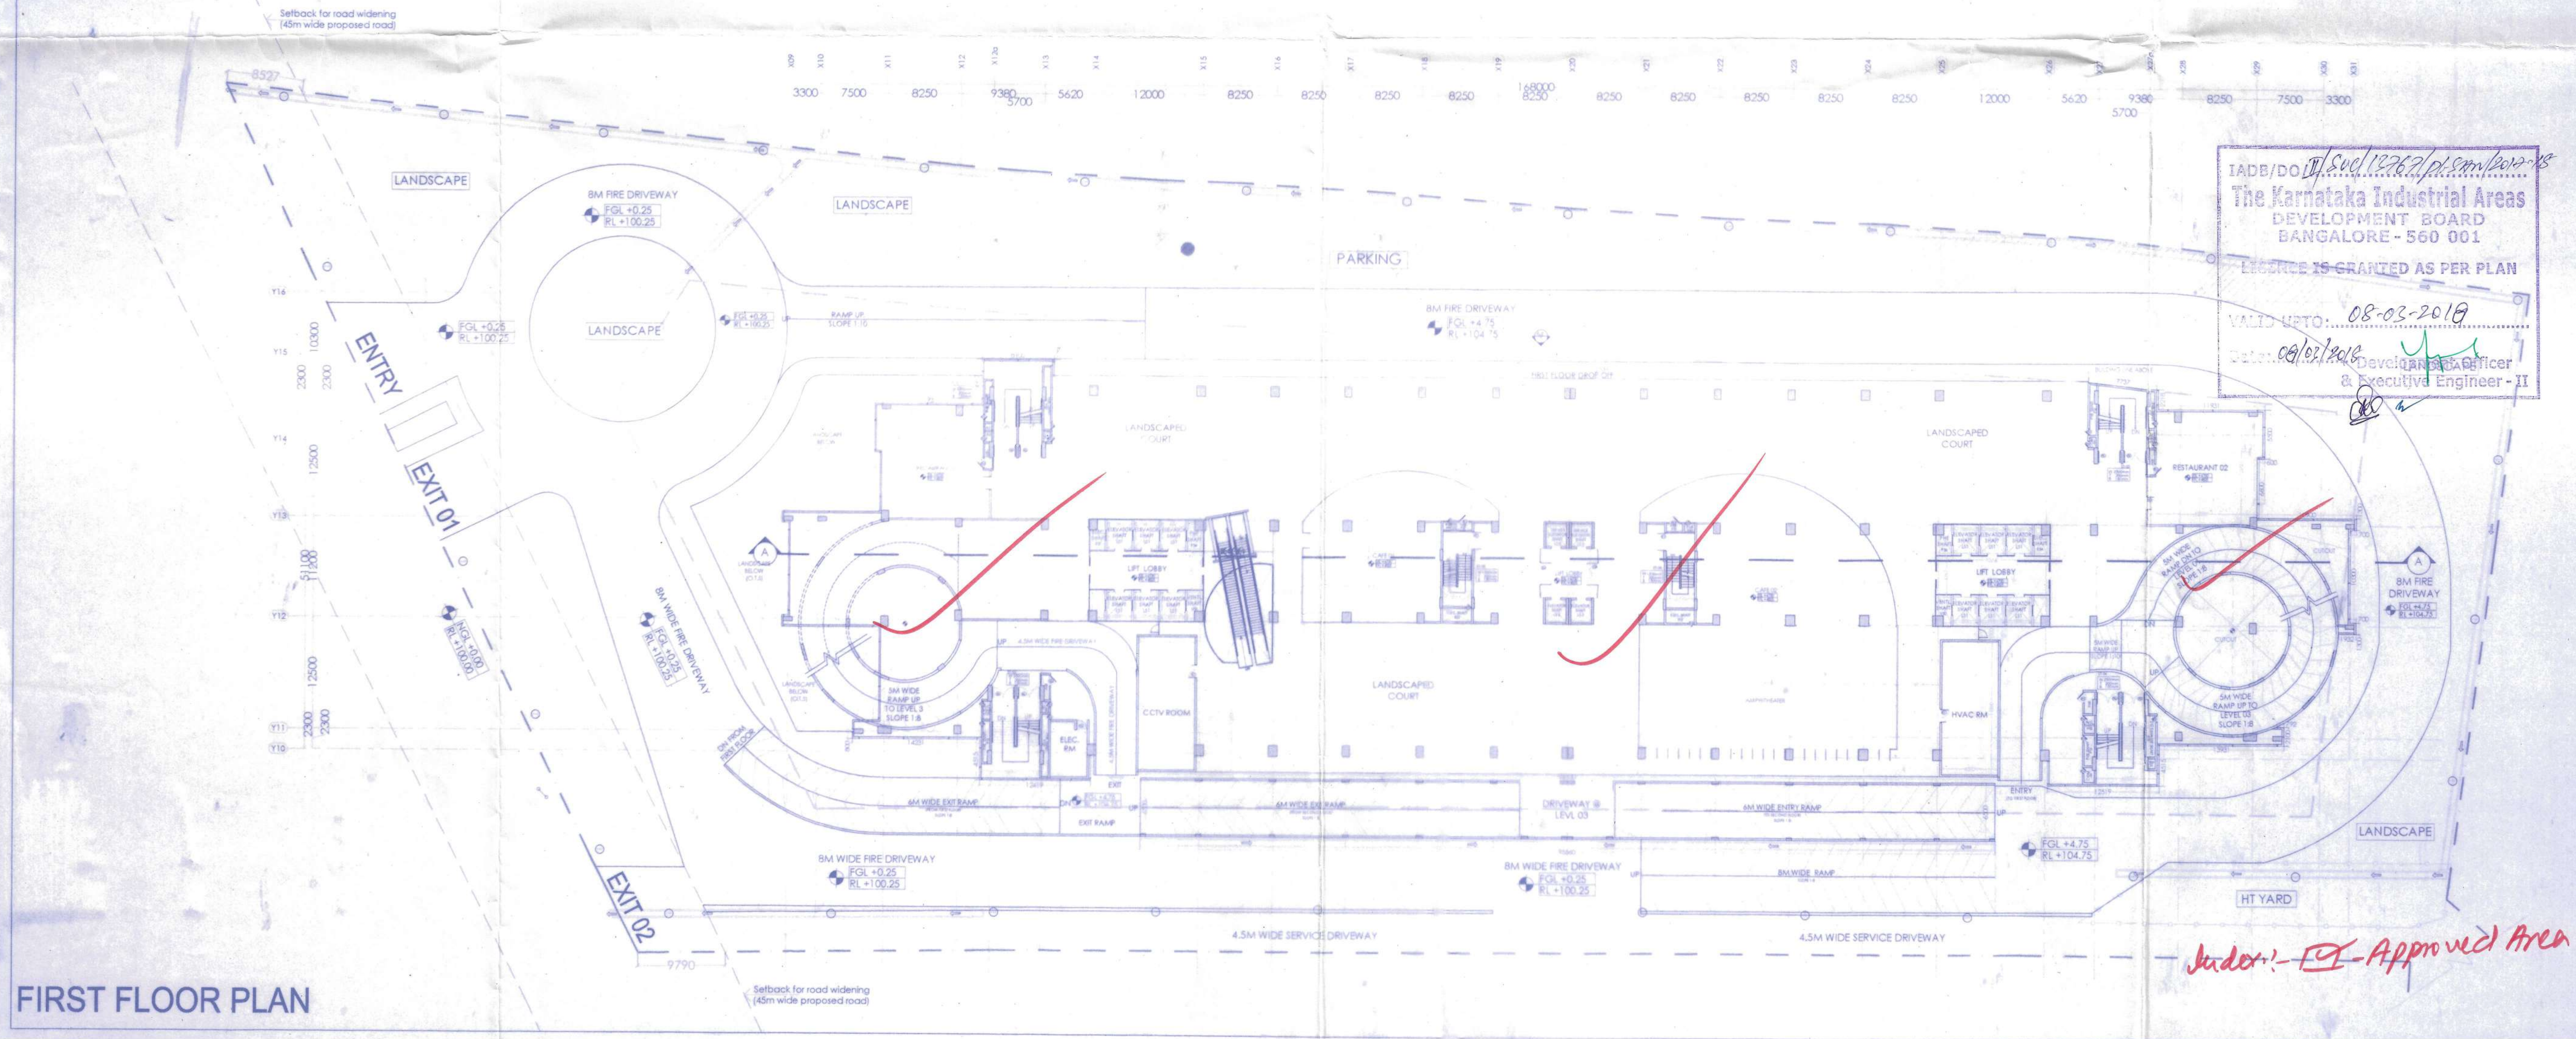

FIRST FLOOR PLAN

Under:- ☐ - Approved Area

IADB/DO IV/SUC/13767/pl-SAM/2017-18
The Karnataka Industrial Areas
DEVELOPMENT BOARD
BANGALORE - 560 001
LICENCE IS GRANTED AS PER PLAN
VALID UPTO: 08-03-2019
Date: 08/03/2018 Development Officer
& Executive Engineer - II

LOCATION PLAN

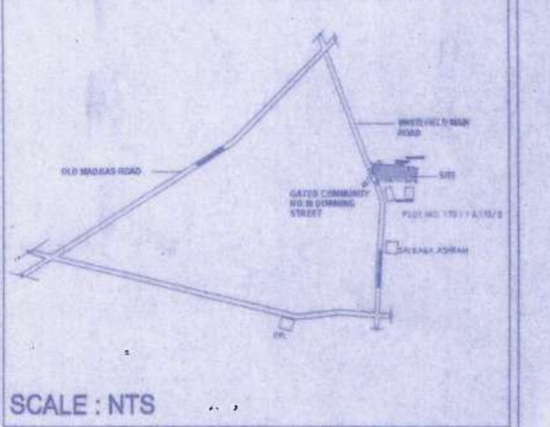

SCALE : NTS

SPECIFIC NOTES

ALL DIMENSIONS ARE IN MILLIMETRES

DETAILS OF RAIN WATER HARVESTING STRUCTURES

(R.W.H)
SECTION OF REFILLED PIT

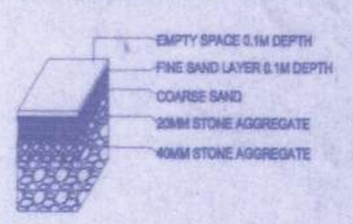

SECTION OF
PERCOLATION PIT

DOOR WINDOW SCHEDULE

SL.No.	Name	Sizes	Location
DOORS:			
01	[illegible]	1400 x 2400mm	Entrance - EAST CORE
02	[illegible]	1300 x 2400mm	Entrance - WEST CORE
03	[illegible]	900 x 2400mm	Bedrooms door
04	[illegible]	900 x 2400mm	Utility
05	[illegible]	800 x 2400mm	Toilets
06	[illegible]	800 x 2400mm	Maid room / EWS Toilets
07	[illegible]	800 x 2400mm	EWS
08	[illegible]	800 x 2400mm	Maids Room - WEST CORE
09	[illegible]	900 x 2400mm	Staircase Lobby
10	[illegible]	600 x 2400mm	Staircase Lobby
11	[illegible]	1200 x 2400mm	Staircase Lobby
12	[illegible]	1200 x 2400mm	Multipurpose Hall-Lvl2
13	[illegible]	1150 x 2400mm	Clubhouse
14	[illegible]	1000 x 2400mm	Toilets- Lvl. 2
15	[illegible]	800 x 2400mm	Toilets- Clubhouse
16	[illegible]	750 x 2400mm	Toilets- Lvl. 2
17	[illegible]	3375 x 2400mm	Balcony
18	[illegible]	4575 x 2400mm	Balcony
19	[illegible]	1500 x 2400mm	Balcony
20	[illegible]	2550 x 2400mm	Enterance lobby
21	[illegible]	2300 x 2400mm	Clubhouse
22	[illegible]	2000 x 2400mm	Terraces
23	[illegible]	2550 x 2400mm	Enterance Lobby
24	[illegible]	1200 x 2400mm	Staircase Lobby
25	[illegible]	800 x 2400mm	Steam / Sauna - Clubhouse
WINDOWS:			
26	[illegible]	1800 x 2100mm	Bedroom
27	[illegible]	1700 x 2100mm	Bedroom
28	[illegible]	1500 x 2100mm	Kitchen
29	[illegible]	900 x 2100mm	Toilets
30	[illegible]	900 x 2100mm	EWS /EWS Toilet / OTS
31	[illegible]	1200 x 2100mm	Staircase Lobby
32	[illegible]	16800 x 3500mm	Living Room
33	[illegible]	14820x 3500mm	Living Room
34	[illegible]	10240x 3500mm	Living Room
35	[illegible]	8400x 3500mm	Bedroom
36	[illegible]	8400x 3500mm	Ventilation shaft / Dining rm

MRUTHYUNJAYA
EMP No. KIADB/Engr/006/2017-18

PROJECT :

"WHITEFIELD TOWERS"
PROPOSED BUILDING (BONSAI) FOR
M/S AUBERGINE PROPERTIES PVT LTD.
ON SY NO 173/1 & 173/2 OF
KANNAMANGALA VILLAGE ,
BIDHARA HALLI HOBLI,
BANGALORE EAST TALUK,
BANGALORE -560067

OWNER'S SIGNATURE

For Aubergine Properties Pvt. Ltd.
Authorised Signatory

ARCHITECT'S SIGNATURE

Antony Kunnel George
COA Regn. No. CA/98/22820
BCC Regn. No. BCC/BL 3.2.3/A-815/98-99

SUBJECT OF THE DRAWING :

GROUND FLOOR PLAN
FIRST FLOOR PLAN

SHEET NO :	1 OF 10
SCALE :	1:400
DATE :	18.02.2011

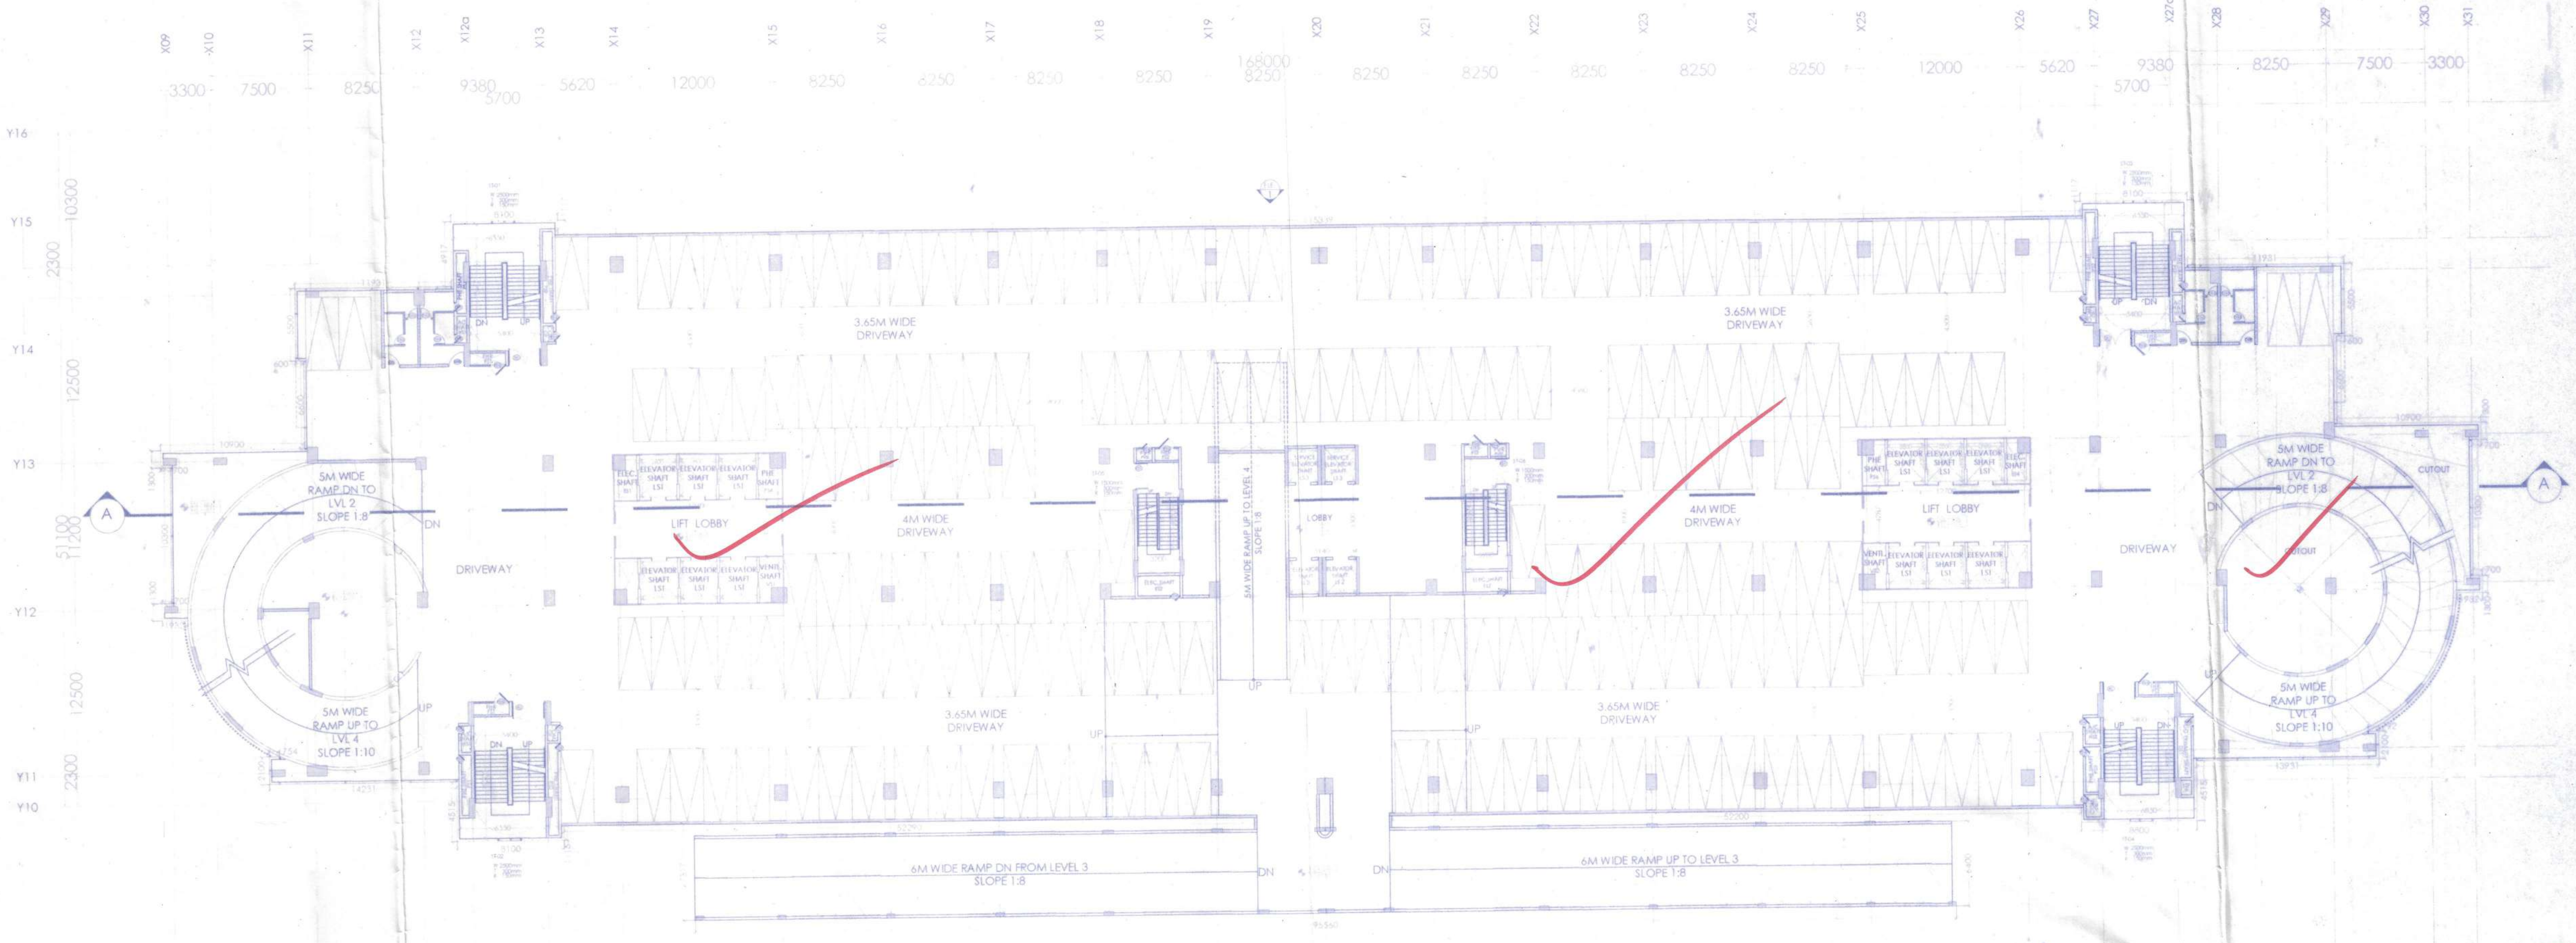
3.65M WIDE DRIVEWAY
4M WIDE DRIVEWAY
DRIVEWAY
LIFT LOBBY
5M WIDE RAMP DN TO LVL 2 SLOPE 1:8
5M WIDE RAMP UP TO LVL 4 SLOPE 1:10
6M WIDE RAMP UP TO LEVEL 4 SLOPE 1:8
6M WIDE RAMP ON FROM LEVEL 3 SLOPE 1:8
6M WIDE RAMP UP TO LEVEL 3 SLOPE 1:8
CUTOUT
168000

SECOND FLOOR PLAN

CAR PARKING NOS.

▭	Stack Car Parks	206 X 2 pcu/lvl
		412 pcu/lvl

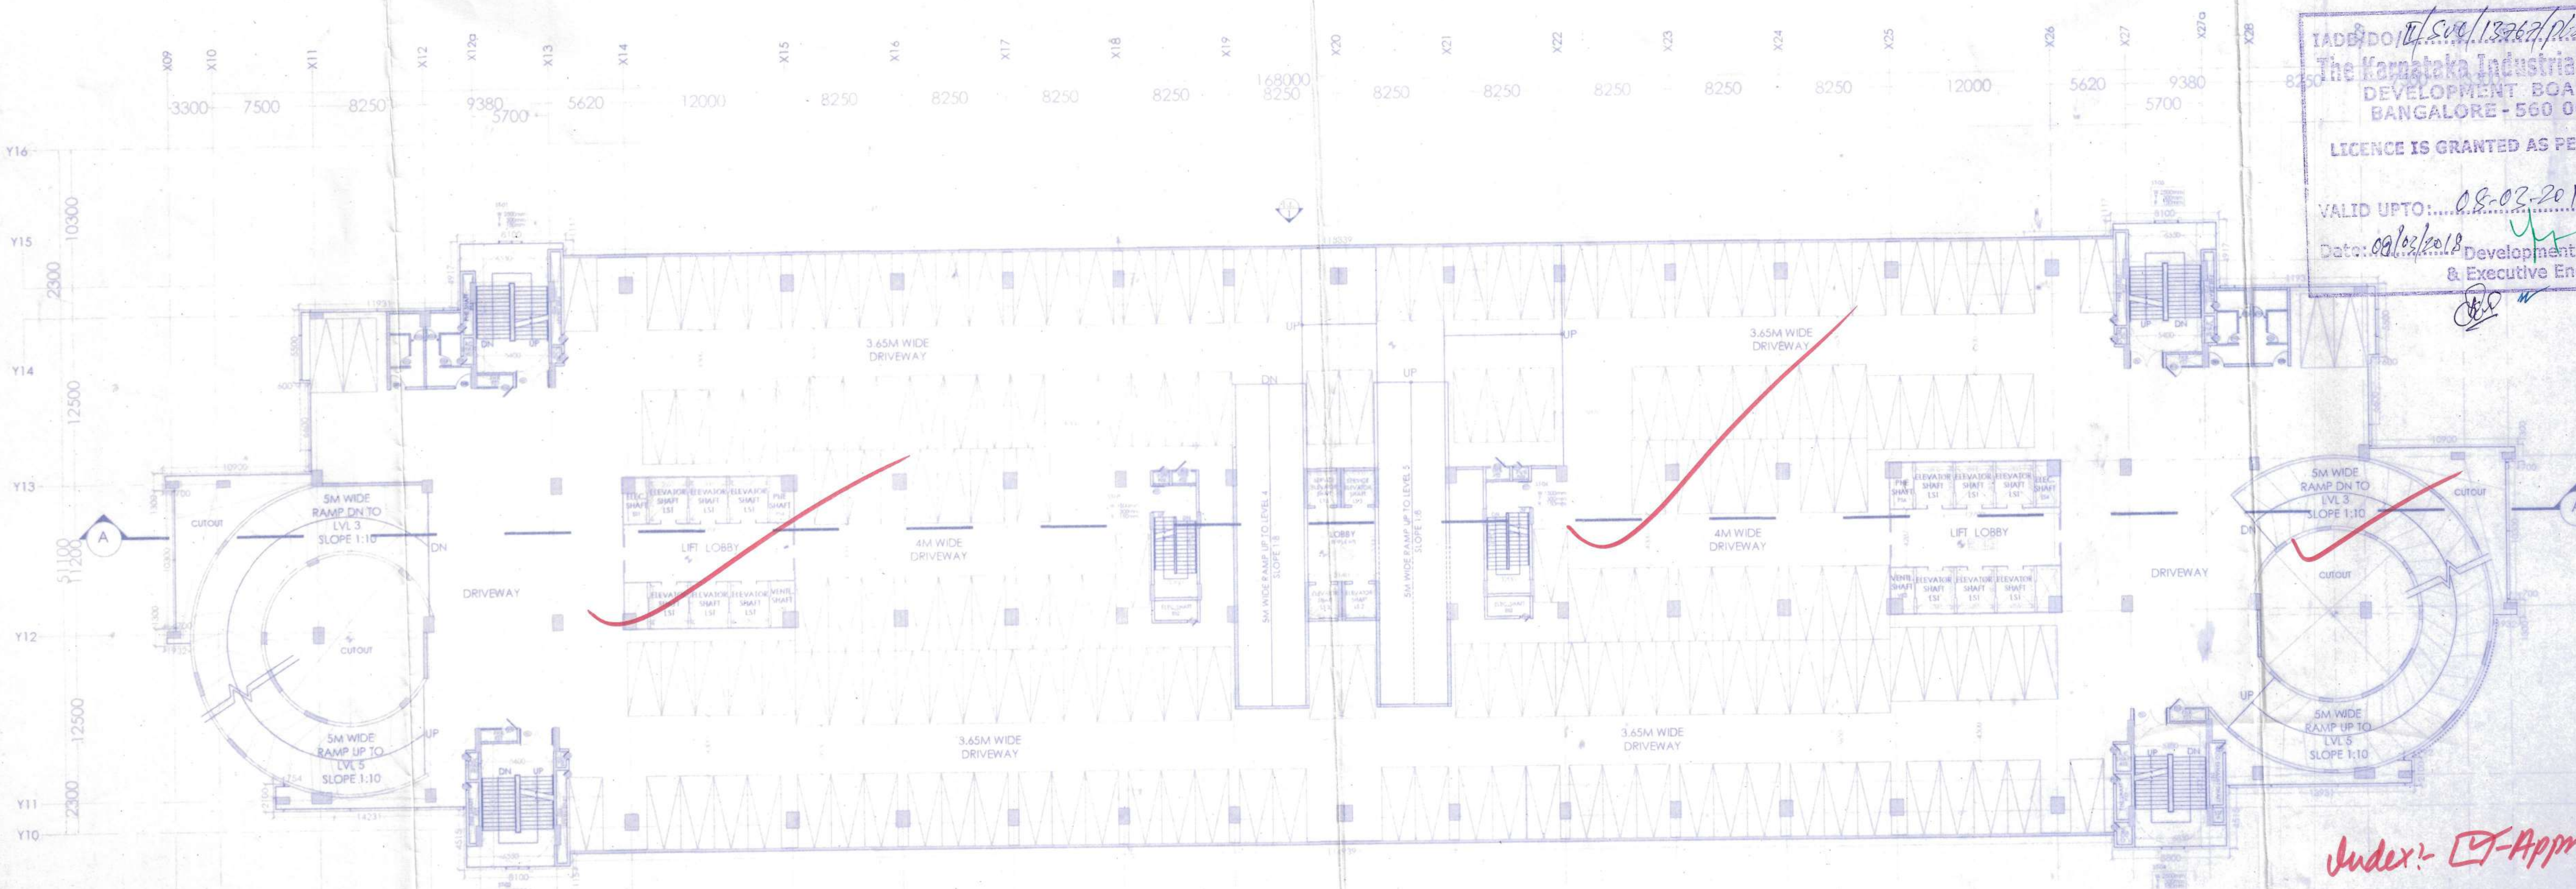
3.65M WIDE DRIVEWAY
4M WIDE DRIVEWAY
DRIVEWAY
LIFT LOBBY
5M WIDE RAMP DN TO LVL 3 SLOPE 1:10
5M WIDE RAMP UP TO LVL 5 SLOPE 1:10
6M WIDE RAMP UP TO LEVEL 4 SLOPE 1:8
6M WIDE RAMP UP TO LEVEL 5 SLOPE 1:8
CUTOUT
168000

Index:- ☑-Approved Area

THIRD FLOOR PLAN

CAR PARKING NOS.

▭	Stack Car Parks	202 X 2 pcu/lvl
		404 pcu/lvl

IADB/DO/II/SVC/13767/PL-SAN/2017-18
The Karnataka Industrial Areas
DEVELOPMENT BOARD
BANGALORE - 560 001

LICENCE IS GRANTED AS PER PLAN

VALID UPTO: 08-03-2018

Date: 09/03/2018 Development Officer
& Executive Engineer - II

LOCATION PLAN

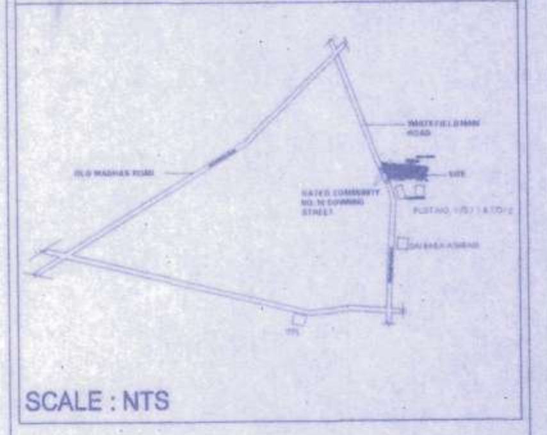

SCALE : NTS

SPECIFIC NOTES

ALL DIMENSIONS ARE IN MILLIMETRES

DETAILS OF RAIN WATER HARVESTING STRUCTURES

(R. W. H)
SECTION OF REFILLED PIT

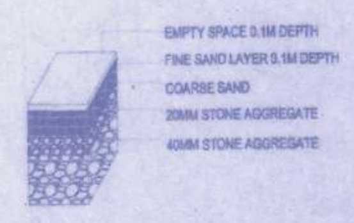

SECTION OF
PERCOLATION PIT

DOOR WINDOW SCHEDULE

SL.No.	Name	Sizes	Location
DOORS:			
01	[illegible]	1400 x 2400mm	Entrance - EAST CORE
02	[illegible]	1300 x 2400mm	Entrance - WEST CORE
03	[illegible]	900 x 2400mm	Bedrooms door
04	[illegible]	900 x 2400mm	Utility
05	[illegible]	800 x 2400mm	Toilets
06	[illegible]	800 x 2400mm	Maid room / EWS Toilets
07	[illegible]	800 x 2400mm	EWS
08	[illegible]	800 x 2400mm	Maids Room - WEST CORE
09	[illegible]	900 x 2400mm	Staircase Lobby
10	[illegible]	600 x 2400mm	Staircase Lobby
11	[illegible]	1200 x 2400mm	Staircase Lobby
12	[illegible]	1200 x 2400mm	Multipurpose Hall-Lvl.2
13	[illegible]	1150 x 2400mm	Clubhouse
14	[illegible]	1000 x 2400mm	Toilets- Lvl. 2
15	[illegible]	800 x 2400mm	Toilets- Clubhouse
16	[illegible]	750 x 2400mm	Toilets- LVL 2
17	[illegible]	3375 x 2400mm	Balcony
18	[illegible]	4575 x 2400mm	Balcony
19	[illegible]	1500 x 2400mm	Balcony
20	[illegible]	2550 x 2400mm	Enterance lobby
21	[illegible]	2300 x 2400mm	Clubhouse
22	[illegible]	2000 x 2400mm	Terraces
23	[illegible]	2550 x 2400mm	Enterance Lobby
24	[illegible]	1200 x 2400mm	Staircase Lobby
25	[illegible]	800 x 2400mm	Steam / Sauna - Clubhouse
WINDOWS:			
26	[illegible]	1800 x 2100mm	Bedroom
27	[illegible]	1700 x 2100mm	Bedroom
28	[illegible]	1300 x 2100mm	Kitchen
29	[illegible]	900 x 2100mm	Toilets
30	[illegible]	900 x 2100mm	EWS /EWS Toilet / OTS
31	[illegible]	1200 x 2100mm	Staircase Lobby
32	[illegible]	16800 x 3500mm	Living Room
33	[illegible]	14820x 3500mm	Living Room
34	[illegible]	10240x 3500mm	Living Room
35	[illegible]	8400x 3500mm	Bedroom
36	[illegible]	8400x 3500mm	Ventilation shaft / Dining rm

MRUTHYUNJAYA
EMP No. KIADB/Engr/006/2017-18

PROJECT :

"WHITEFIELD TOWERS"
PROPOSED BUILDING (BONSAI) FOR
M/S AUBERGINE PROPERTIES PVT LTD.
ON SY NO 173/1 & 173/2 OF
KANNAMANGALA VILLAGE ,
BIDHARA HALLI HOBLI,
BANGALORE EAST TALUK,
BANGALORE -560067

OWNER'S SIGNATURE

For Aubergine Properties Pvt. Ltd.

Authorised Signatory

ARCHITECT'S SIGNATURE

Antony Kunnel George
COA Regn. No. CA/98/22820
BCC Regn. No. BCC/BL-3.2.3/A-815/98

SUBJECT OF THE DRAWING :

SECOND FLOOR PLAN
THIRD FLOOR PLAN

SHEET NO :	2 OF 10
SCALE :	1:300
DATE :	18.02.2011

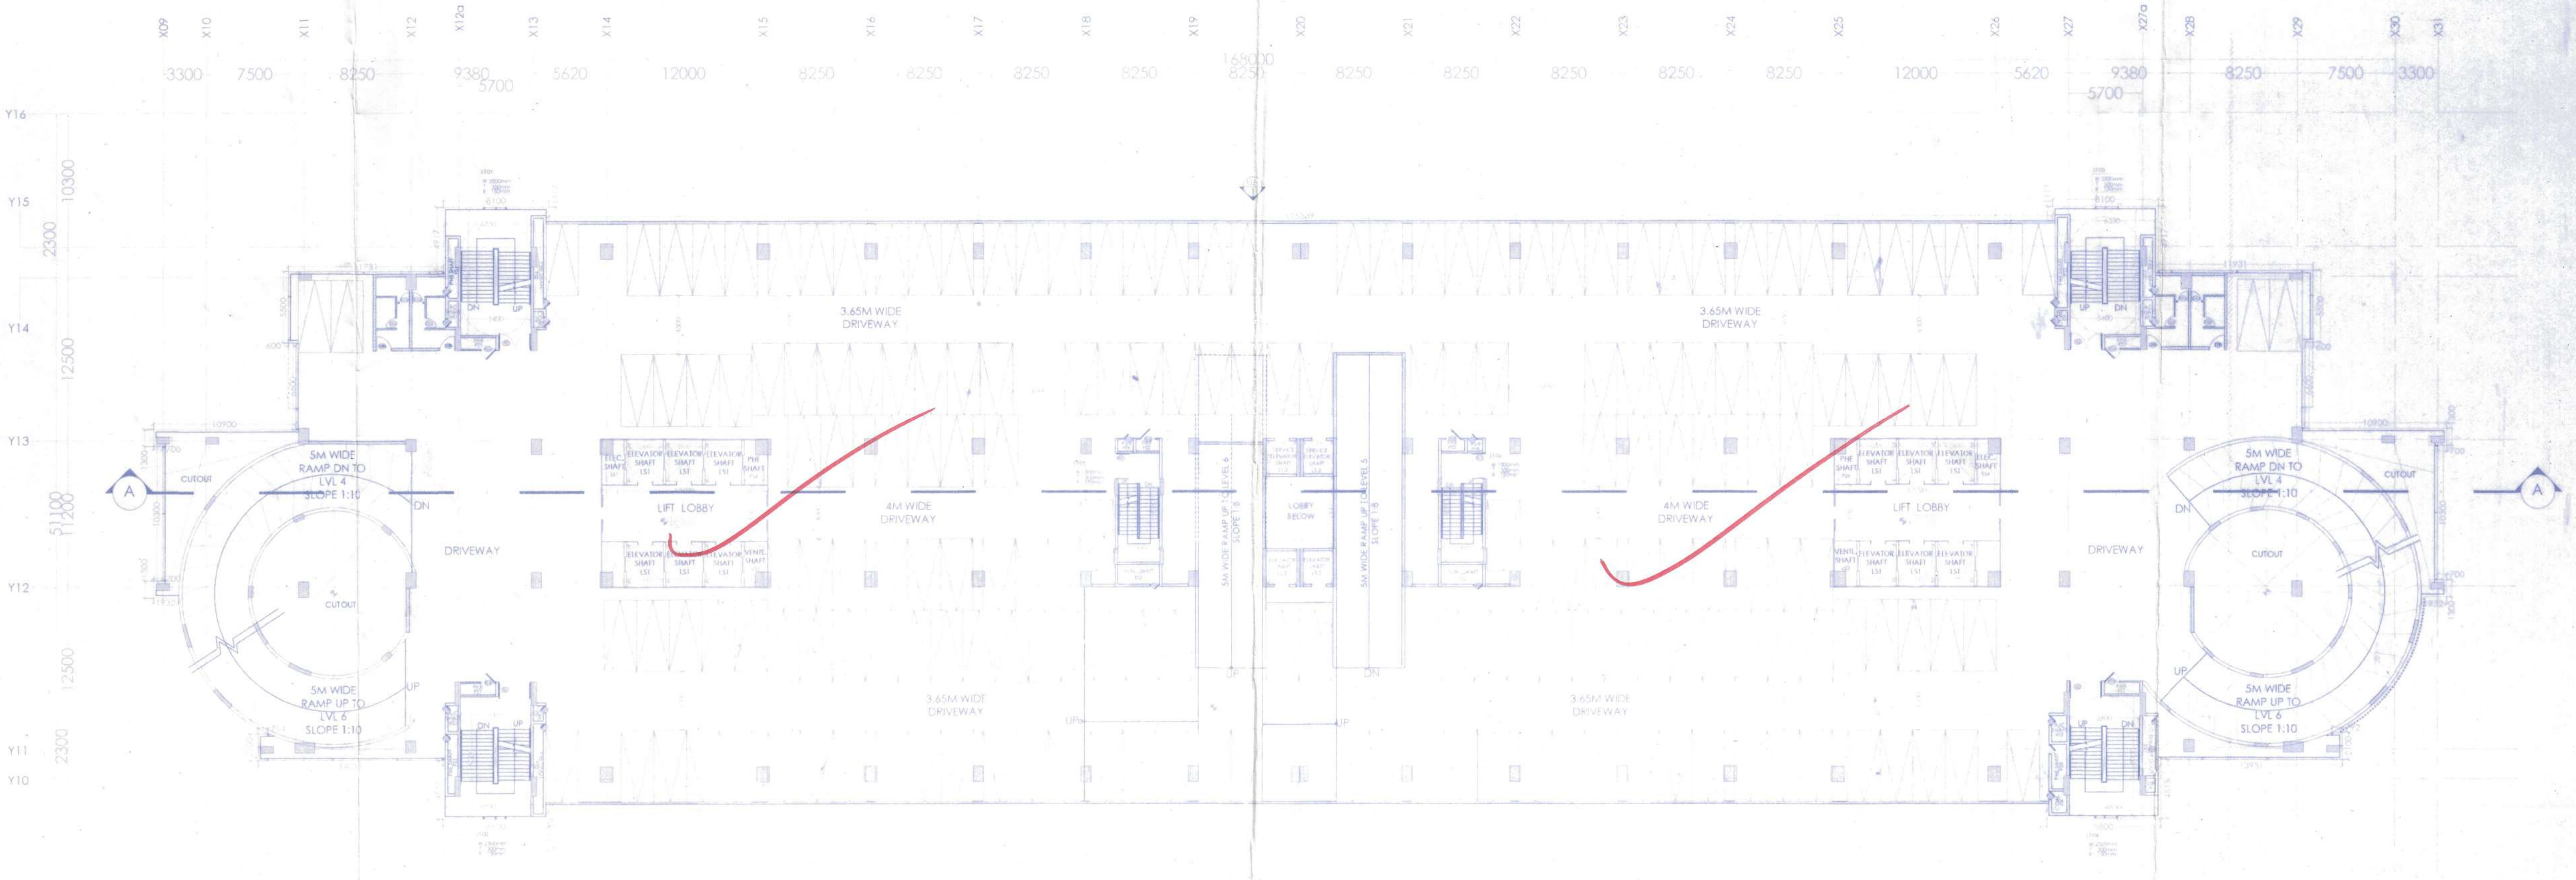

FOURTH FLOOR PLAN

CAR PARKING NOS.
▨ Std.Car Parks 204 pcu/M

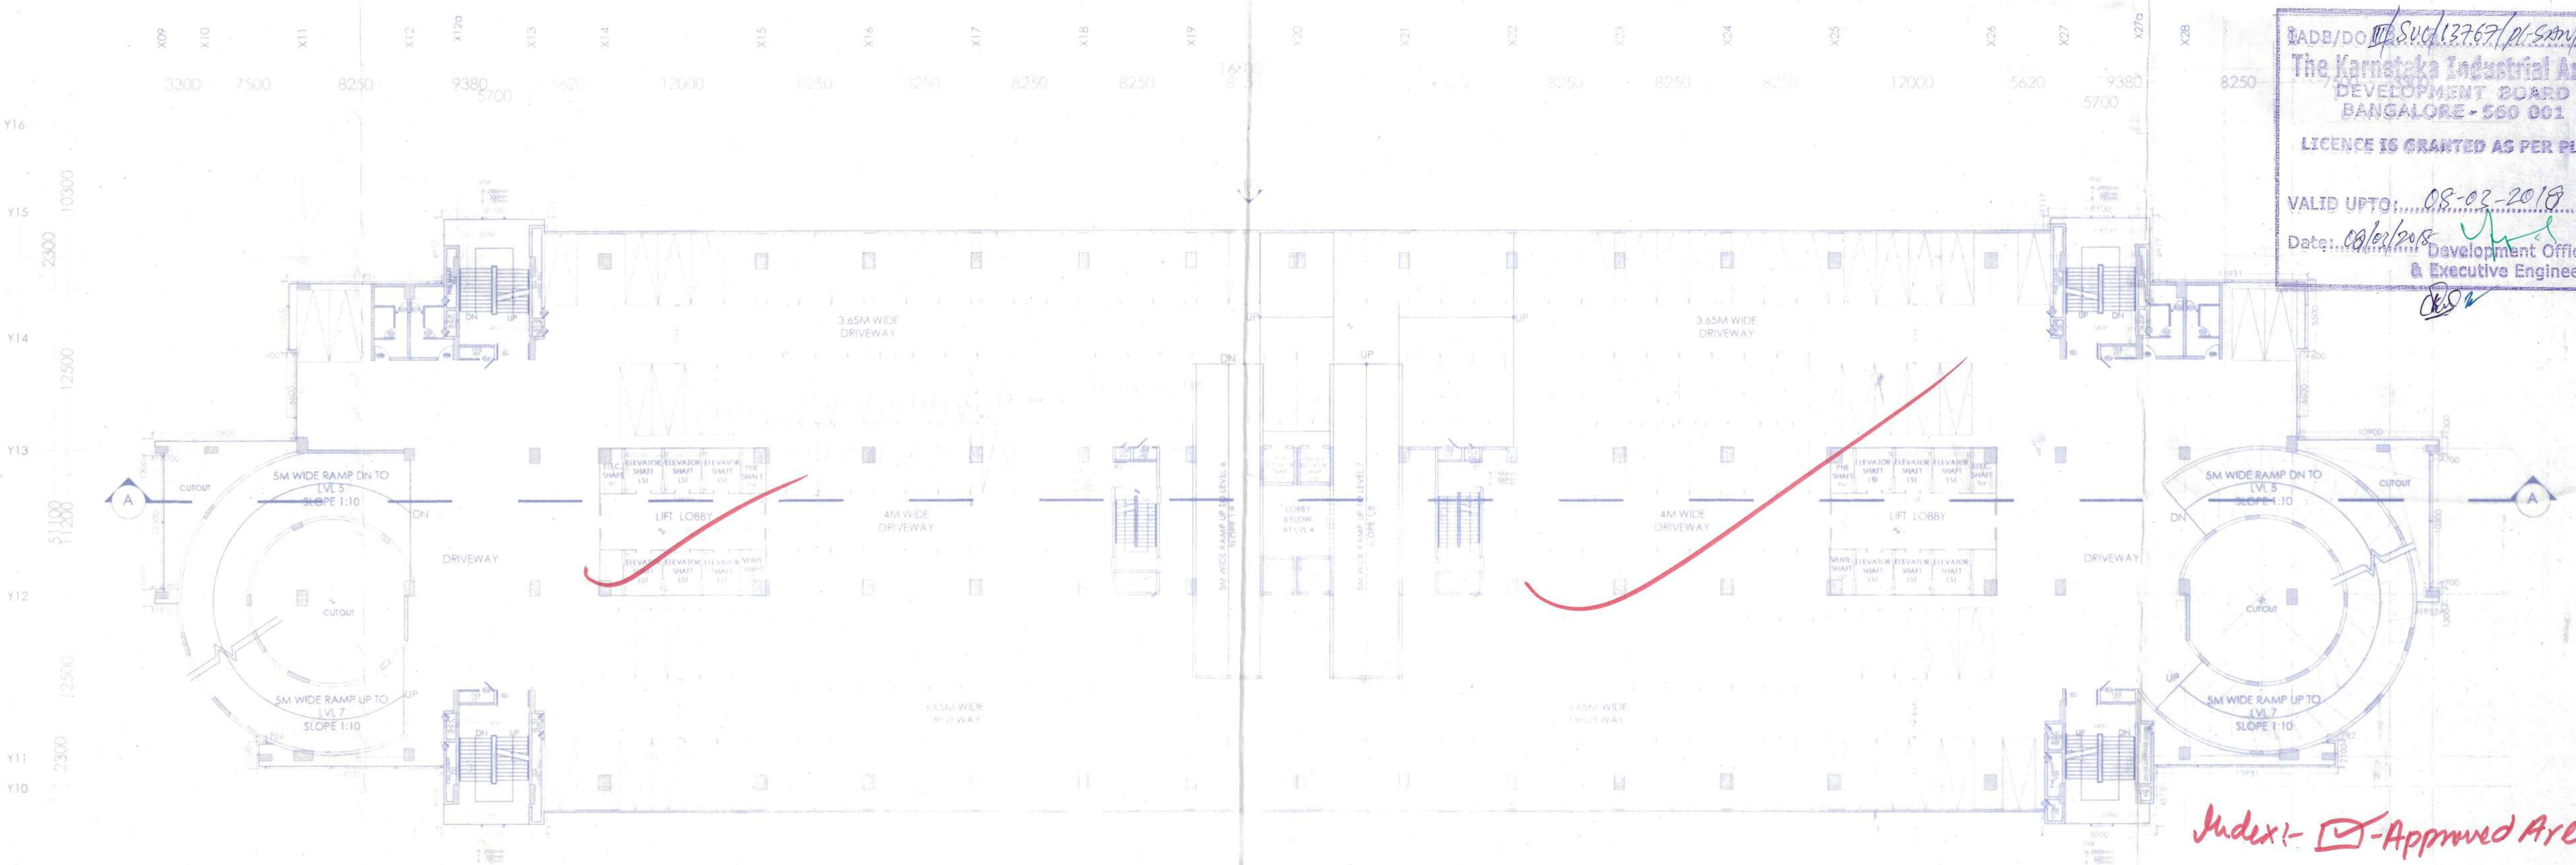

Index:- ☑-Approved Area.

FIFTH FLOOR PLAN

CAR PARKING NOS.
▨ Std.Car Parks 202 pcu/M

IADB/DO/III/SVC/13767/PL-SAN/2017-18
The Karnataka Industrial Areas
DEVELOPMENT BOARD
BANGALORE - 560 001
LICENCE IS GRANTED AS PER PLAN
VALID UPTO:...08-02-2018
Date:...08/02/2018 Development Officer
& Executive Engineer - II

LOCATION PLAN

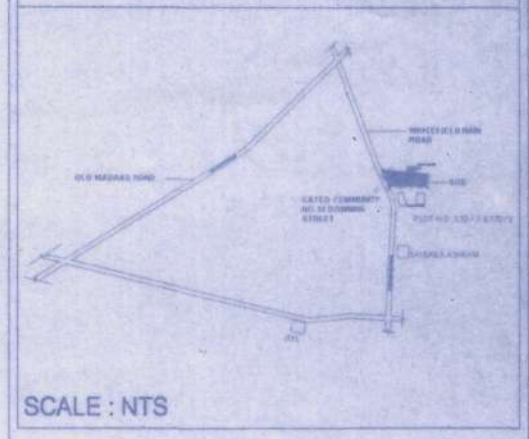

SCALE : NTS

SPECIFIC NOTES

ALL DIMENSIONS ARE IN MILLIMETRES

DETAILS OF RAIN WATER HARVESTING STRUCTURES

(R.W.H)
SECTION OF REFILLED PIT

SECTION OF PERCOLATION PIT

DOOR WINDOW SCHEDULE

SL.No.	Name	Sizes	Location
DOORS:			
01	[illegible]	1400 x 2400mm	Entrance - EAST CORE
02	[illegible]	1300 x 2400mm	Entrance - WEST CORE
03	[illegible]	900 x 2400mm	Bedrooms door
04	[illegible]	900 x 2400mm	Utility
05	[illegible]	800 x 2400mm	Toilets
06	[illegible]	800 x 2400mm	Maid room / EWS Toilets
07	[illegible]	800 x 2400mm	EWS
08	[illegible]	800 x 2400mm	Maids Room - WEST CORE
09	[illegible]	900 x 2400mm	Staircase Lobby
10	[illegible]	600 x 2400mm	Staircase Lobby
11	[illegible]	1200 x 2400mm	Staircase Lobby
12	[illegible]	1200 x 2400mm	Multipurpose Hall-Lvl2
13	[illegible]	1150 x 2400mm	Clubhouse
14	[illegible]	1000 x 2400mm	Toilets- Lvl. 2
15	[illegible]	800 x 2400mm	Toilets- Clubhouse
16	[illegible]	750 x 2400mm	Toilets- Lvl. 2
17	[illegible]	3375 x 2400mm	Balcony
18	[illegible]	4575 x 2400mm	Balcony
19	[illegible]	1500 x 2400mm	Balcony
20	[illegible]	2550 x 2400mm	Enterance lobby
21	[illegible]	2300 x 2400mm	Clubhouse
22	[illegible]	2000 x 2400mm	Terraces
23	[illegible]	2550 x 2400mm	Enterance Lobby
24	[illegible]	1200 x 2400mm	Staircase Lobby
25	[illegible]	800 x 2400mm	Steam / Sauna - Clubhouse
WINDOWS:			
26	[illegible]	1800 x 2100mm	Bedroom
27	[illegible]	1700 x 2100mm	Bedroom
28	[illegible]	1500 x 2100mm	Kitchen
29	[illegible]	900 x 2100mm	Toilets
30	[illegible]	900 x 2100mm	EWS /EWS Toilet / OTS
31	[illegible]	1200 x 2100mm	Staircase Lobby
32	[illegible]	16800 x 3500mm	Living Room
33	[illegible]	14820x 3500mm	Living Room
34	[illegible]	10240x 3500mm	Living Room
35	[illegible]	8400x 3500mm	Bedroom
36	[illegible]	8400x 3500mm	Ventilation shaft / Dining rm

MRUTHYUNJAYA
EMP No. KIADB/Engr/006/2017-18.

PROJECT :

"WHITEFIELD TOWERS"
PROPOSED BUILDING (BONSAI) FOR
M/S AUBERGINE PROPERTIES PVT LTD.
ON SY NO 173/1 & 173/2 OF
KANNAMANGALA VILLAGE ,
BIDHARA HALLI HOBLI,
BANGALORE EAST TALUK,
BANGALORE -560067

OWNER'S SIGNATURE

For Aubergine Properties Pvt. Ltd.

Authorised Signatory

ARCHITECT'S SIGNATURE

Antony Kunnel George
COA Regn. No. CA/98/22820
BCC Regn. No. BCC/BL-3.2.3/A-816/98

SUBJECT OF THE DRAWING :

FOURTH FLOOR PLAN
FIFTH FLOOR PLAN

SHEET NO :	3 OF 10
SCALE :	1:300
DATE :	18.02.2011

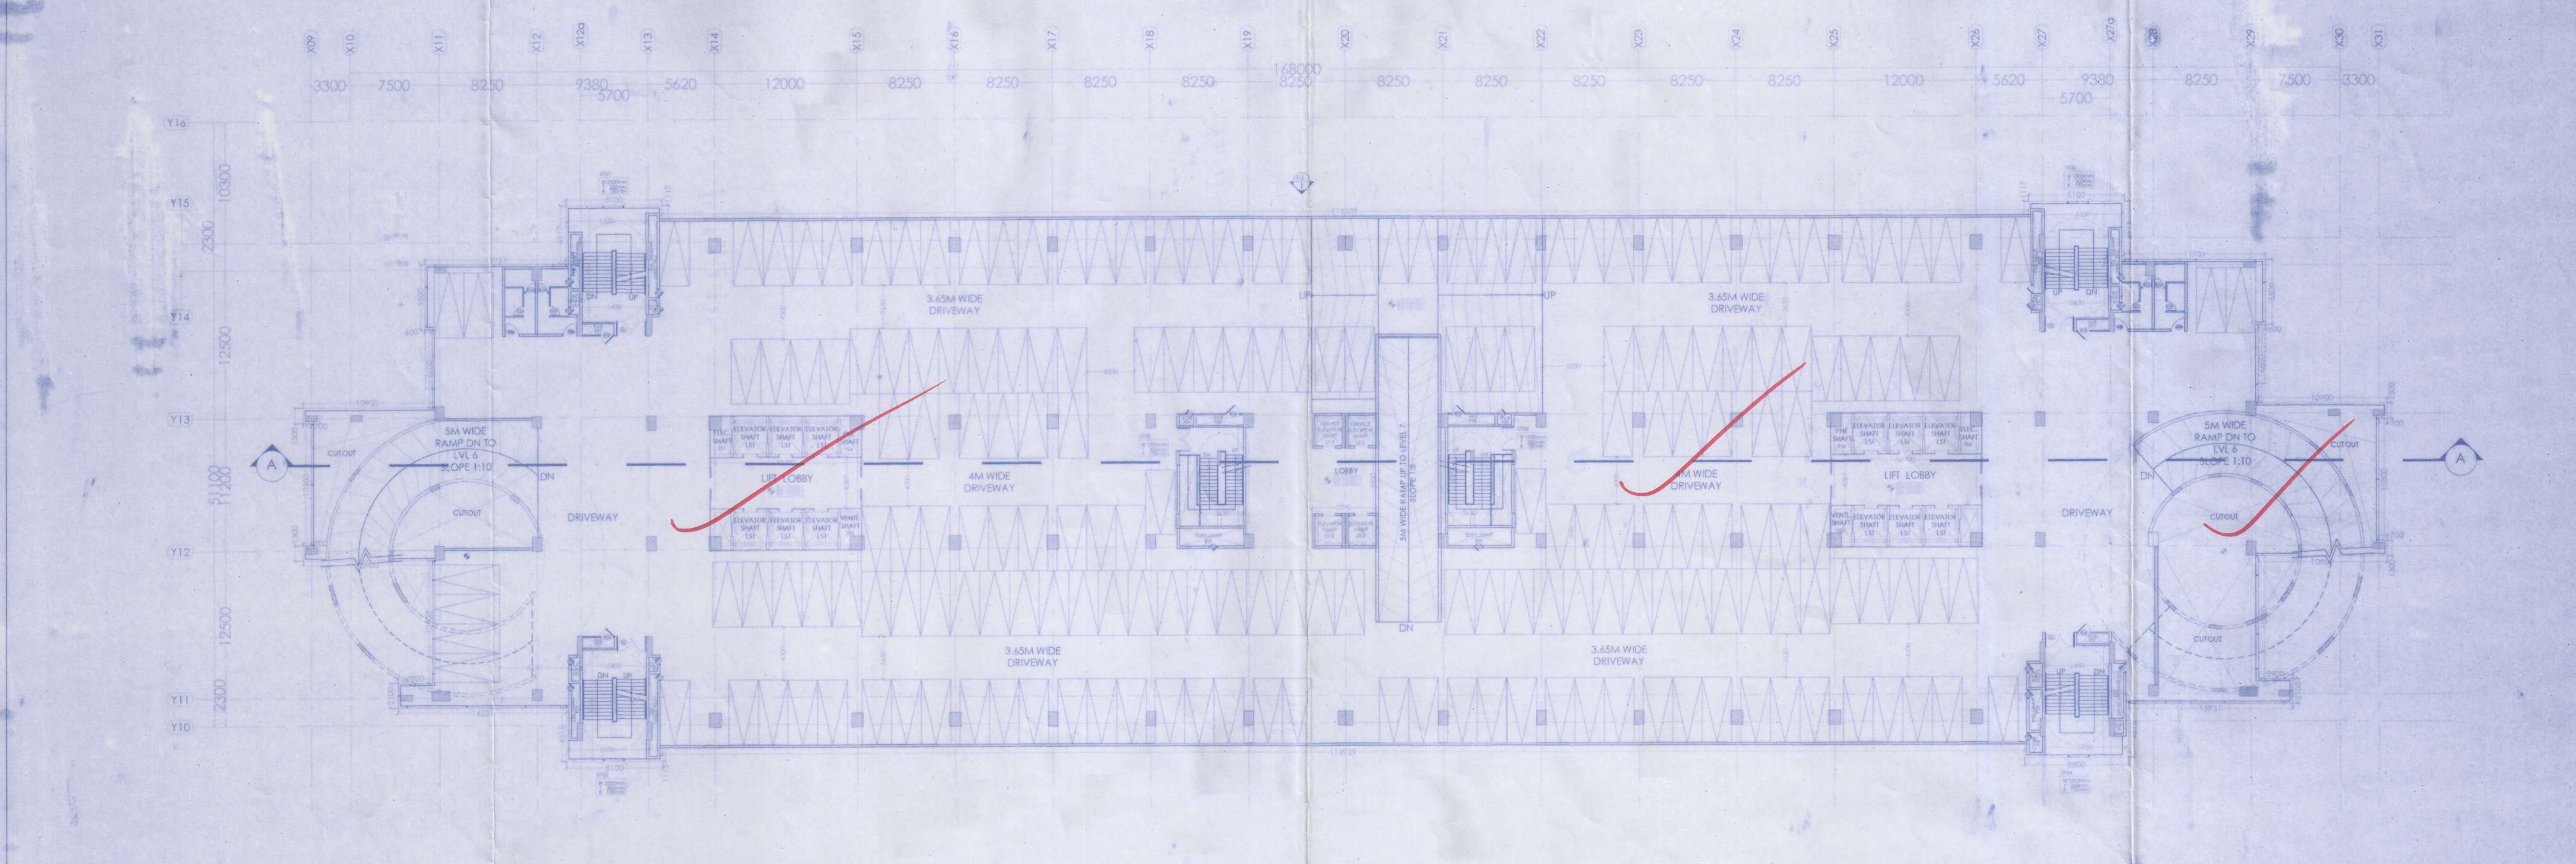

SIXTH FLOOR PLAN

CAR PARKING NOS.

▭	Std Car Parks	210 pcu/lvl

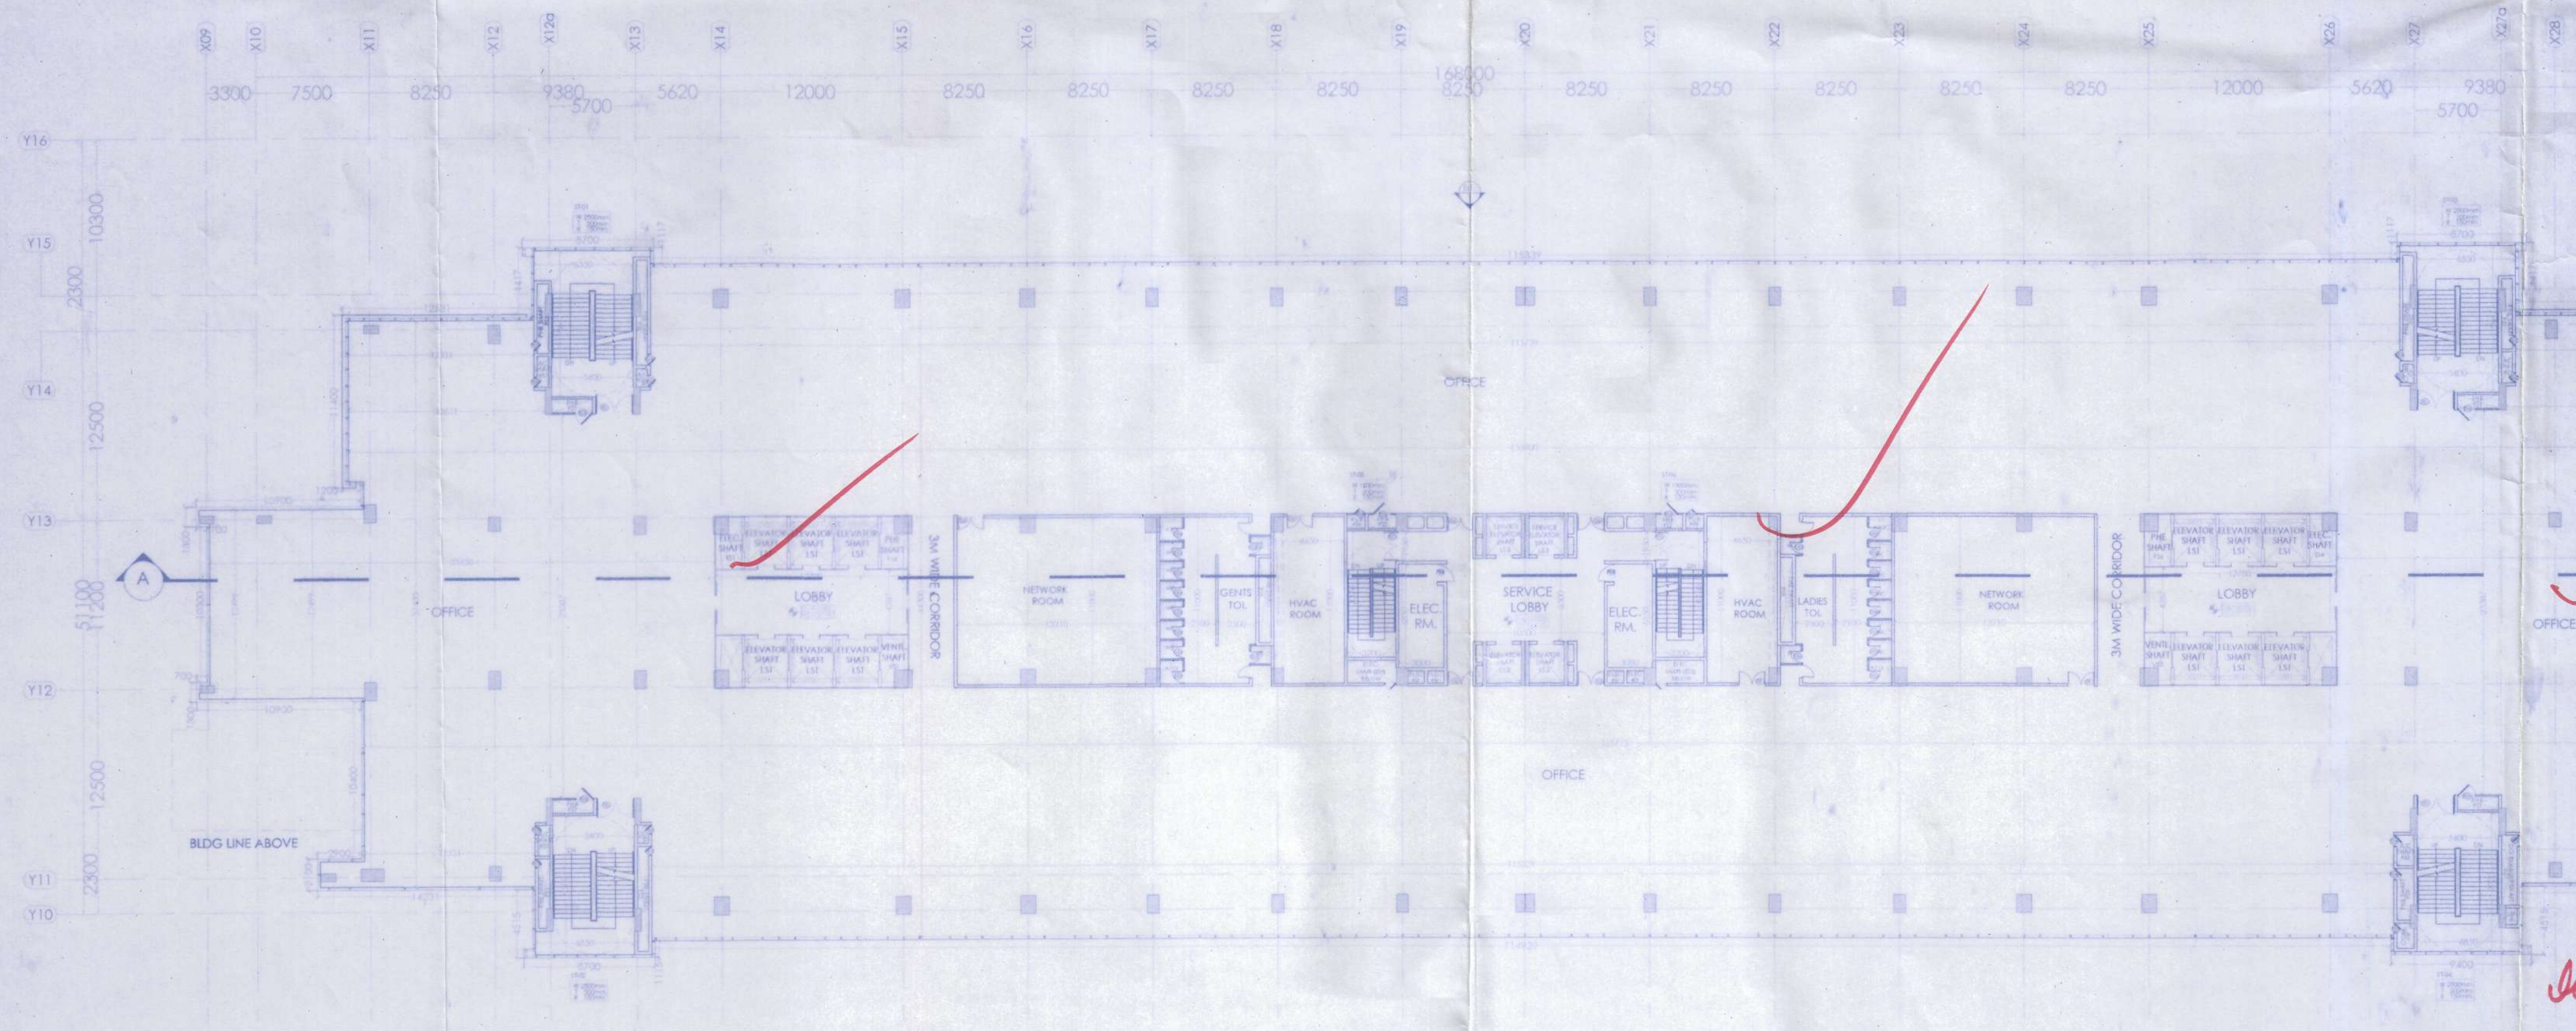

SEVENTH FLOOR PLAN

IADB/DO/ II/SOC/13767/PL-SAN/2017-18
The Karnataka Industrial Areas
DEVELOPMENT BOARD
BANGALORE-560 001
LICENCE IS GRANTED AS PER PLAN
VALID UPTO: 08-03-2018
Date: 08/03/2018
Development Officer
& Executive Engineer - II

Index: ☑ - Approved Area

LOCATION PLAN

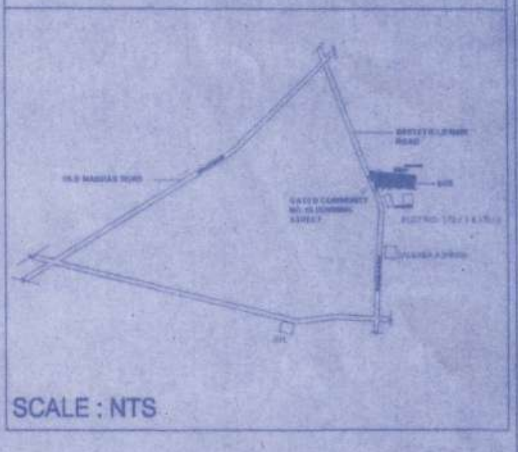

SCALE : NTS

SPECIFIC NOTES

ALL DIMENSIONS ARE IN MILLIMETRES

DETAILS OF RAIN WATER HARVESTING STRUCTURES

(R.W.H)
SECTION OF REFILLED PIT

SECTION OF
PERCOLATION PIT

DOOR WINDOW SCHEDULE

Sl.No.	Name	Sizes	Location
DOORS:			
01	[illegible]	1400 x 2400mm	Entrance - EAST CORE
02	[illegible]	1300 x 2400mm	Entrance - WEST CORE
03	[illegible]	900 x 2400mm	Bedrooms door
04	[illegible]	900 x 2400mm	Utility
05	[illegible]	800 x 2400mm	Toilets
06	[illegible]	800 x 2400mm	Maid room / EWS Toilets
07	[illegible]	800 x 2400mm	EWS
08	[illegible]	800 x 2400mm	Maids Room - WEST CORE
09	[illegible]	900 x 2400mm	Staircase Lobby
10	[illegible]	600 x 2400mm	Staircase Lobby
11	[illegible]	1200 x 2400mm	Staircase Lobby
12	[illegible]	1200 x 2400mm	Multipurpose Hall-Lvl2
13	[illegible]	1150 x 2400mm	Clubhouse
14	[illegible]	1009 x 2400mm	Toilets- LvL 2
15	[illegible]	800 x 2400mm	Toilets- Clubhouse
16	[illegible]	750 x 2400mm	Toilets- LvL 2
17	[illegible]	3375 x 2400mm	Balcony
18	[illegible]	4575 x 2400mm	Balcony
19	[illegible]	1500 x 2400mm	Balcony
20	[illegible]	2550 x 2400mm	Enterance lobby
21	[illegible]	2300 x 2400mm	Clubhouse
22	[illegible]	2000 x 2400mm	Terraces
23	[illegible]	2550 x 2400mm	Enterance Lobby
24	[illegible]	1200 x 2400mm	Staircase Lobby
25	[illegible]	800 x 2400mm	Steam / Sauna - Clubhouse
WINDOWS:			
26	[illegible]	1800 x 2100mm	Bedroom
27	[illegible]	1700 x 2100mm	Bedroom
28	[illegible]	1500 x 2100mm	Kitchen
29	[illegible]	900 x 2100mm	Toilets
30	[illegible]	900 x 2100mm	EWS /EWS Toilet / OTS
31	[illegible]	1200 x 2100mm	Staircase Lobby
32	[illegible]	16800 x 3500mm	Living Room
33	[illegible]	14820x 3500mm	Living Room
34	[illegible]	10240x 3500mm	Living Room
35	[illegible]	8400x 3500mm	Bedroom
36	[illegible]	8400x 3500mm	Ventilation shaft / Dining rm

MRUTHYUNJAYA
EMP No. KIADB/Engr/006/2017-18

PROJECT :

"WHITEFIELD TOWERS".
PROPOSED BUILDING (BONSAI) FOR
M/S AUBERGINE PROPERTIES PVT LTD.
ON SY NO 173/1 & 173/2 OF
KANNAMANGALA VILLAGE ,
BIDHARA HALLI HOBLI,
BANGALORE EAST TALUK,
BANGALORE -560067

OWNER'S SIGNATURE

For Aubergine Properties Pvt. Ltd.

Authorised Signatory

ARCHITECT'S SIGNATURE

Antony Kunnel George
COA Regn. No. CA/98/22020
BCC Regn. No. BCC/BL-3.2.3/A-815/98

SUBJECT OF THE DRAWING :

SIXTH FLOOR PLAN
SEVENTH FLOOR PLAN

SHEET NO :	4 OF 10
SCALE :	1:300
DATE :	18.02.2011

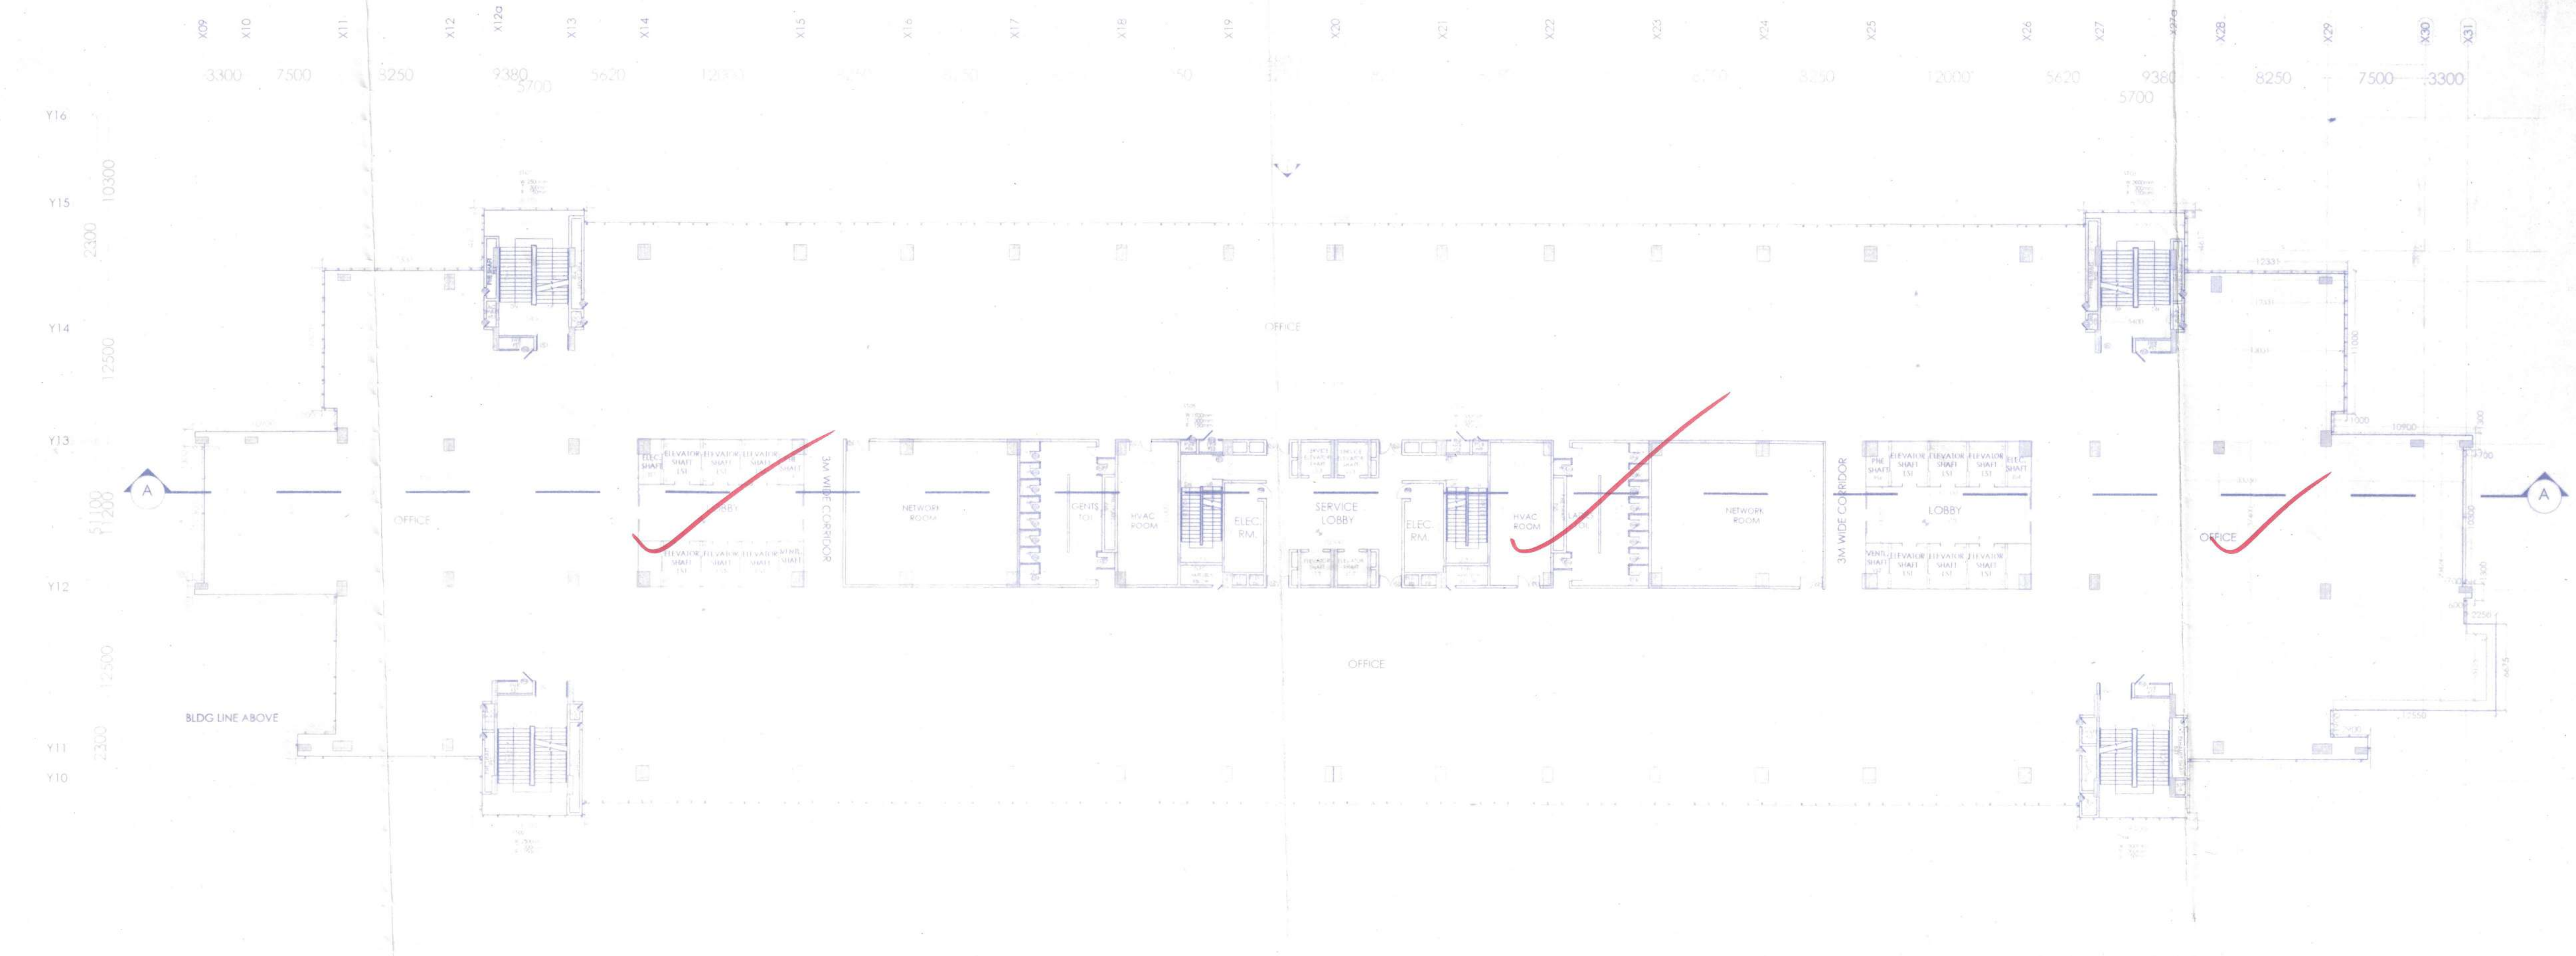

EIGHTH FLOOR PLAN

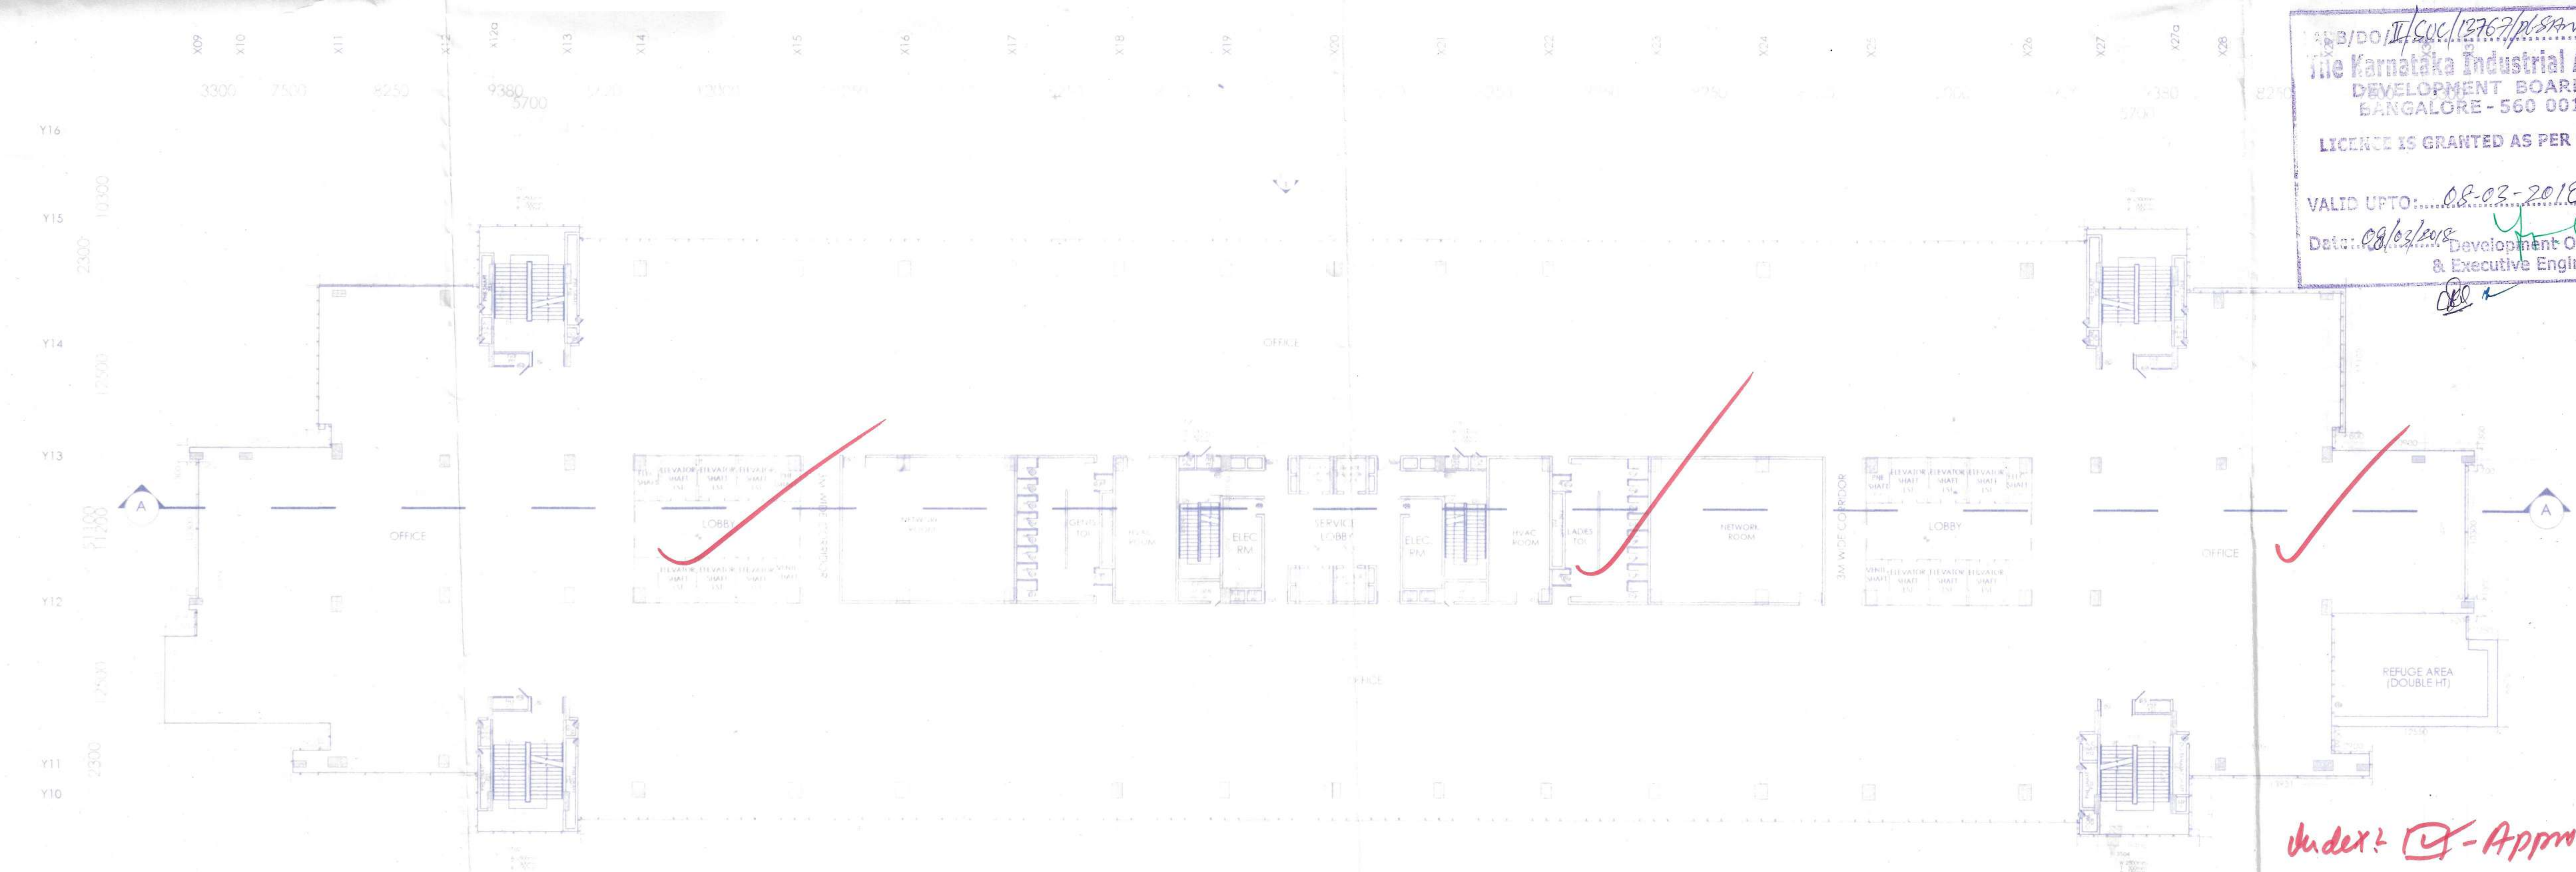

NINTH FLOOR PLAN

KIADB/DO/II/SUC/13767/pl-SAN/2017-18
The Karnataka Industrial Areas
DEVELOPMENT BOARD
BANGALORE - 560 001
LICENCE IS GRANTED AS PER PLAN
VALID UPTO: 08-03-2018
Date: 08/03/2018 Development Officer
& Executive Engineer - II

Index: ☑ - Approved Area.

LOCATION PLAN

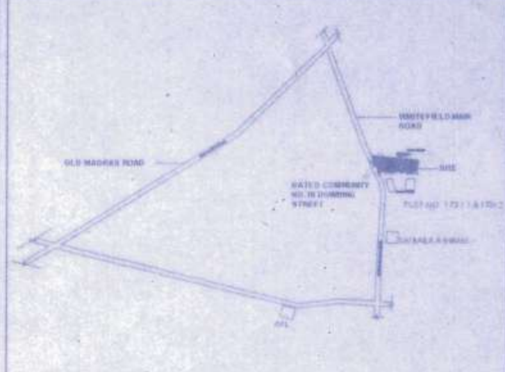

SCALE : NTS

SPECIFIC NOTES

ALL DIMENSIONS ARE IN MILLIMETRES

DETAILS OF RAIN WATER HARVESTING STRUCTURES

(R.W.H)
SECTION OF REFILLED PIT

SECTION OF
PERCOLATION PIT

DOOR WINDOW SCHEDULE

SL.No.	Name	Sizes	Location
DOORS:			
01	[illegible]	1400 x 2400mm	Entrance - EAST CORE
02	[illegible]	1300 x 2400mm	Entrance - WEST CORE
03	[illegible]	900 x 2400mm	Bedrooms door
04	[illegible]	900 x 2400mm	Utility
05	[illegible]	800 x 2400mm	Toilets
06	[illegible]	800 x 2400mm	Maid room / EWS Toilets
07	[illegible]	800 x 2400mm	EWS
08	[illegible]	800 x 2400mm	Maids Room - WEST CORE
09	[illegible]	900 x 2400mm	Staircase Lobby
10	[illegible]	600 x 2400mm	Staircase Lobby
11	[illegible]	1200 x 2400mm	Staircase Lobby
12	[illegible]	1200 x 2400mm	Multipurpose Hall-Lvl2
13	[illegible]	1150 x 2400mm	Clubhouse
14	[illegible]	1000 x 2400mm	Toilets- Lvl 2
15	[illegible]	800 x 2400mm	Toilets- Clubhouse
16	[illegible]	750 x 2400mm	Toilets- Lvl 2
17	[illegible]	3375 x 2400mm	Balcony
18	[illegible]	4575 x 2400mm	Balcony
19	[illegible]	1500 x 2400mm	Balcony
20	[illegible]	2550 x 2400mm	Enterance lobby
21	[illegible]	2300 x 2400mm	Clubhouse
22	[illegible]	2000 x 2400mm	Terraces
23	[illegible]	2550 x 2400mm	Enterance Lobby
24	[illegible]	1200 x 2400mm	Staircase Lobby
25	[illegible]	800 x 2400mm	Steam / Sauna - Clubhouse
WINDOWS:			
26	[illegible]	1800 x 2100mm	Bedroom
27	[illegible]	1700 x 2100mm	Bedroom
28	[illegible]	1500 x 2100mm	Kitchen
29	[illegible]	900 x 2100mm	Toilets
30	[illegible]	900 x 2100mm	EWS /EWS Toilet / OTS
31	[illegible]	1200 x 2100mm	Staircase Lobby
32	[illegible]	16800 x 3500mm	Living Room
33	[illegible]	14820x 3500mm	Living Room
34	[illegible]	10240x 3500mm	Living Room
35	[illegible]	8400x 3500mm	Bedroom
36	[illegible]	8400x 3500mm	Ventilation shaft / Dining rm

MRUTHYUNJAYA
EMP No. KIADB/Engr/006/2017-18

PROJECT :

"WHITEFIELD TOWERS"
PROPOSED BUILDING (BONSAI) FOR
M/S AUBERGINE PROPERTIES PVT LTD.
ON SY NO 173/1 & 173/2 OF
KANNAMANGALA VILLAGE ,
BIDHARA HALLI HOBLI,
BANGALORE EAST TALUK,
BANGALORE -560067

OWNER'S SIGNATURE

For Aubergine Properties Pvt. Ltd.
Authorised Signatory

ARCHITECT'S SIGNATURE

Antony Kunnel George
COA Regn. No. CA/98/22820
BCC Regn. No. BCC BL-3.2.3/A-815/98

SUBJECT OF THE DRAWING :

EIGHTH FLOOR PLAN
NINTH FLOOR PLAN

SHEET NO :	5 OF 10
SCALE :	1:300
DATE :	18.02.2011

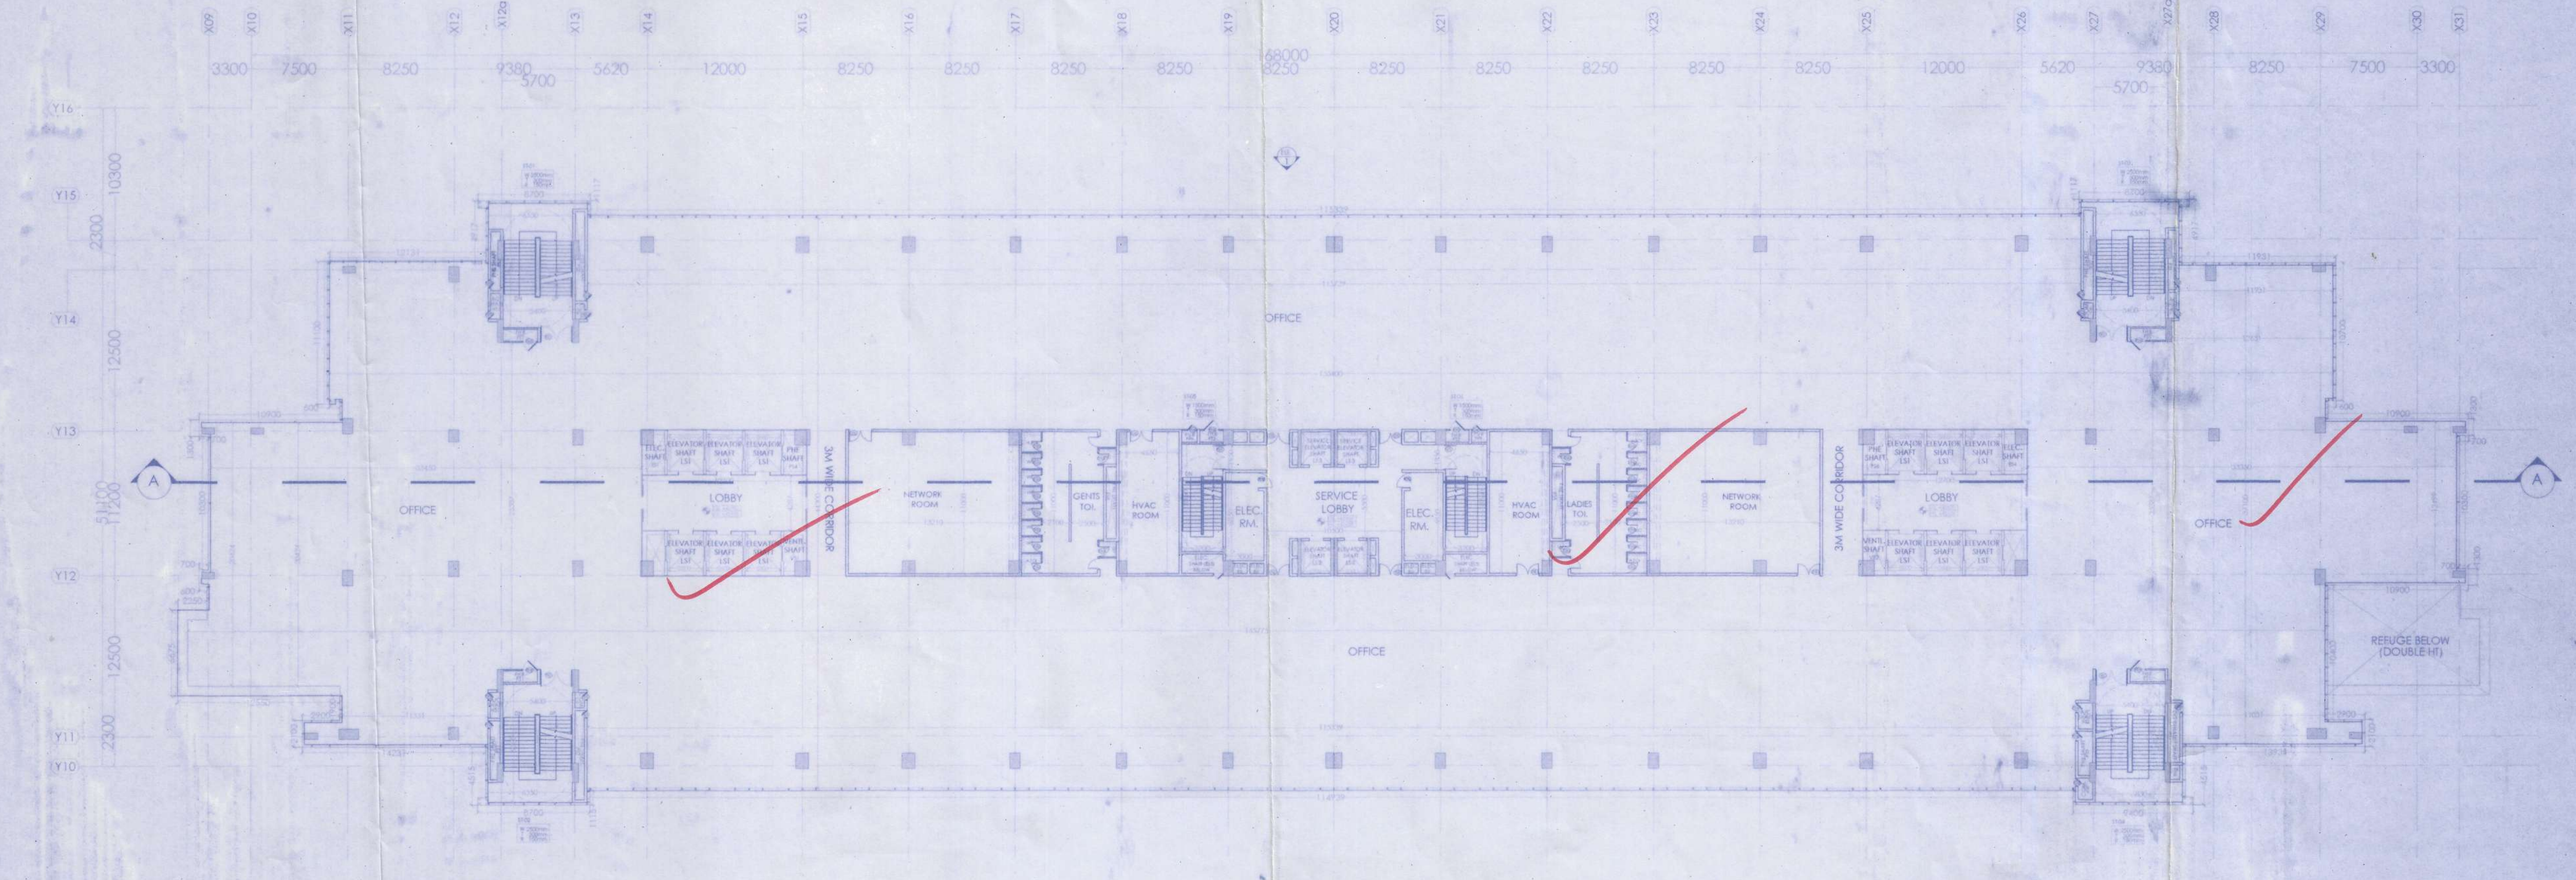

TENTH FLOOR PLAN

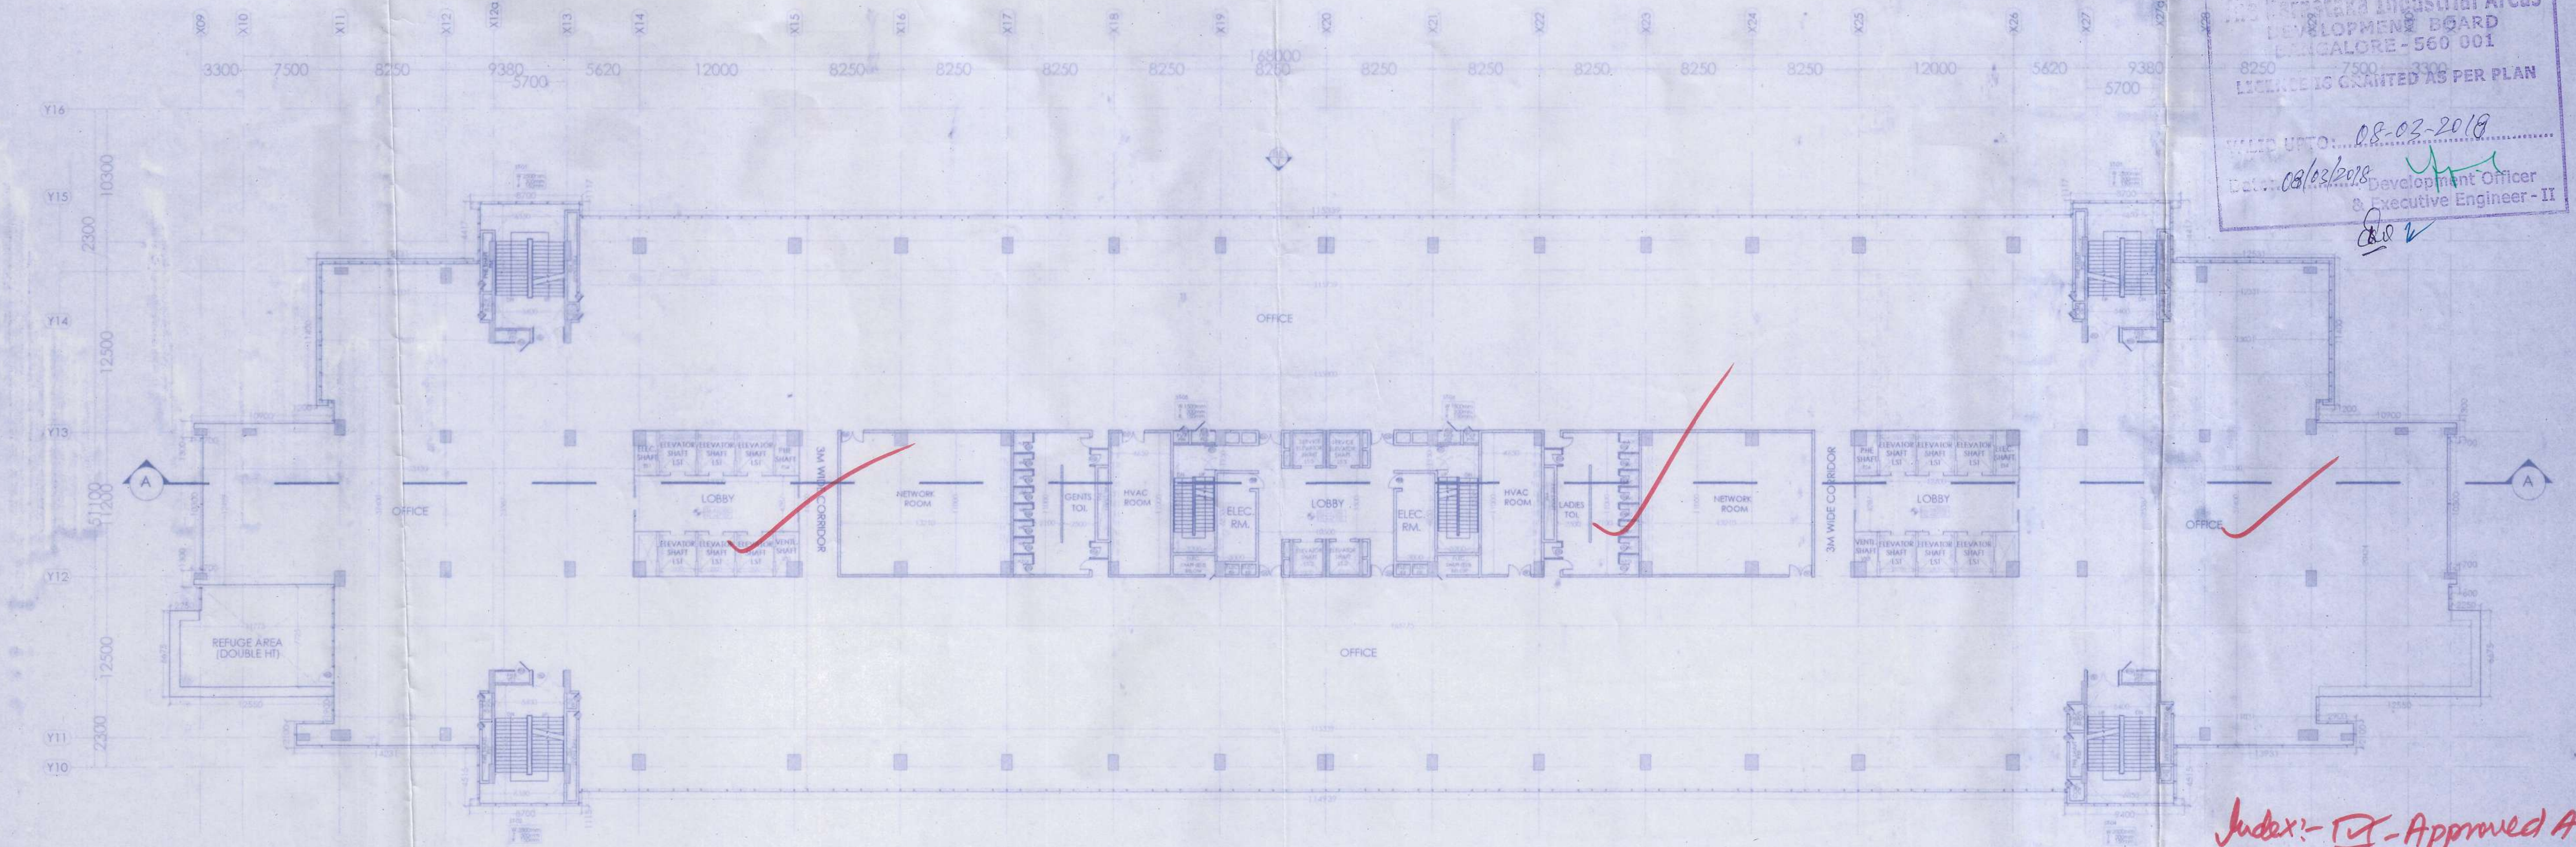

ELEVENTH FLOOR PLAN

AEE/DO/II/SUC/13767/PUSAN/2017-18
The Karnataka Industrial Areas
DEVELOPMENT BOARD
BANGALORE - 560 001
LICENCE IS GRANTED AS PER PLAN
VALID UPTO: 08-03-2018
Date: 08/03/2018 Development Officer
& Executive Engineer - II

Index:- ☑ - Approved Area.

LOCATION PLAN

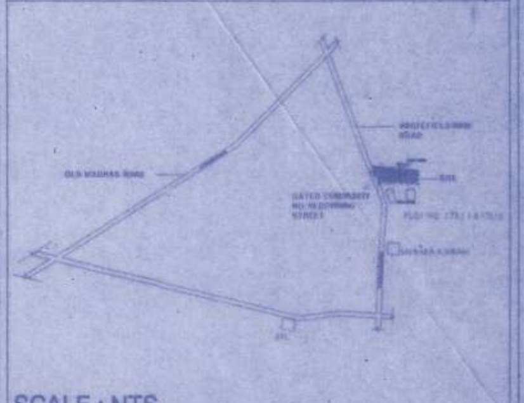

SCALE : NTS

SPECIFIC NOTES

ALL DIMENSIONS ARE IN MILLIMETRES

DETAILS OF RAIN WATER HARVESTING STRUCTURES

(R.W.H)
SECTION OF REFILLED PIT

SECTION OF
PERCOLATION PIT

DOOR WINDOW SCHEDULE

SL.No.	Name	Sizes	Location
DOORS:			
01	[illegible]	1400 x 2400mm	Entrance - EAST CORE
02	[illegible]	1300 x 2400mm	Entrance - WEST CORE
03	[illegible]	900 x 2400mm	Bedrooms door
04	[illegible]	900 x 2400mm	Utility
05	[illegible]	800 x 2400mm	Toilets
06	[illegible]	800 x 2400mm	Maid room / EWS Toilets
07	[illegible]	800 x 2400mm	EWS
08	[illegible]	800 x 2400mm	Maids Room - WEST CORE
09	[illegible]	900 x 2400mm	Staircase Lobby
10	[illegible]	600 x 2400mm	Staircase Lobby
11	[illegible]	1200 x 2400mm	Staircase Lobby
12	[illegible]	1200 x 2400mm	Multipurpose Hall-Lvl.2
13	[illegible]	1150 x 2400mm	Clubhouse
14	[illegible]	1000 x 2400mm	Toilets- Lvl. 2
15	[illegible]	800 x 2400mm	Toilets- Clubhouse
16	[illegible]	750 x 2400mm	Toilets- Lvl. 2
17	[illegible]	3375 x 2400mm	Balcony
18	[illegible]	4575 x 2400mm	Balcony
19	[illegible]	1500 x 2400mm	Balcony
20	[illegible]	2550 x 2400mm	Enterance lobby
21	[illegible]	2300 x 2400mm	Clubhouse
22	[illegible]	2000 x 2400mm	Terraces
23	[illegible]	2550 x 2400mm	Enterance Lobby
24	[illegible]	1200 x 2400mm	Staircase Lobby
25	[illegible]	800 x 2400mm	Steam / Sauna - Clubhouse
WINDOWS:			
26	[illegible]	1800 x 2100mm	Bedroom
27	[illegible]	1700 x 2100mm	Bedroom
28	[illegible]	1500 x 2100mm	Kitchen
29	[illegible]	900 x 2100mm	Toilets
30	[illegible]	900 x 2100mm	EWS /EWS Toilet / OTS
31	[illegible]	1200 x 2100mm	Staircase Lobby
32	[illegible]	16800 x 3500mm	Living Room
33	[illegible]	14820x 3500mm	Living Room
34	[illegible]	10240x 3500mm	Living Room
35	[illegible]	8400x 3500mm	Bedroom
36	[illegible]	8400x 3500mm	Ventilation shaft / Dining rm

MRUTHYUNJAYA
EMP No. KIADB/Engr/006/2017-18

PROJECT :

"WHITEFIELD TOWERS"
PROPOSED BUILDING (BONSAI) FOR
M/S AUBERGINE PROPERTIES PVT LTD.
ON SY NO 173/1 & 173/2 OF
KANNAMANGALA VILLAGE ,
BIDHARA HALLI HOBLI,
BANGALORE EAST TALUK,
BANGALORE -560067

OWNER'S SIGNATURE

For Aubergine Properties Pvt. Ltd.

Authorised Signatory

ARCHITECT'S SIGNATURE

Antony Kunnel George
COA Regn. No. CA/98/22820
BCC Regn. No. BCC/BL-3.2.3/A-815/98-99

SUBJECT OF THE DRAWING :

TENTH FLOOR PLAN
ELEVENTH FLOOR PLAN

SHEET NO :	6 OF 10
SCALE :	1:300
DATE :	18.02.2011

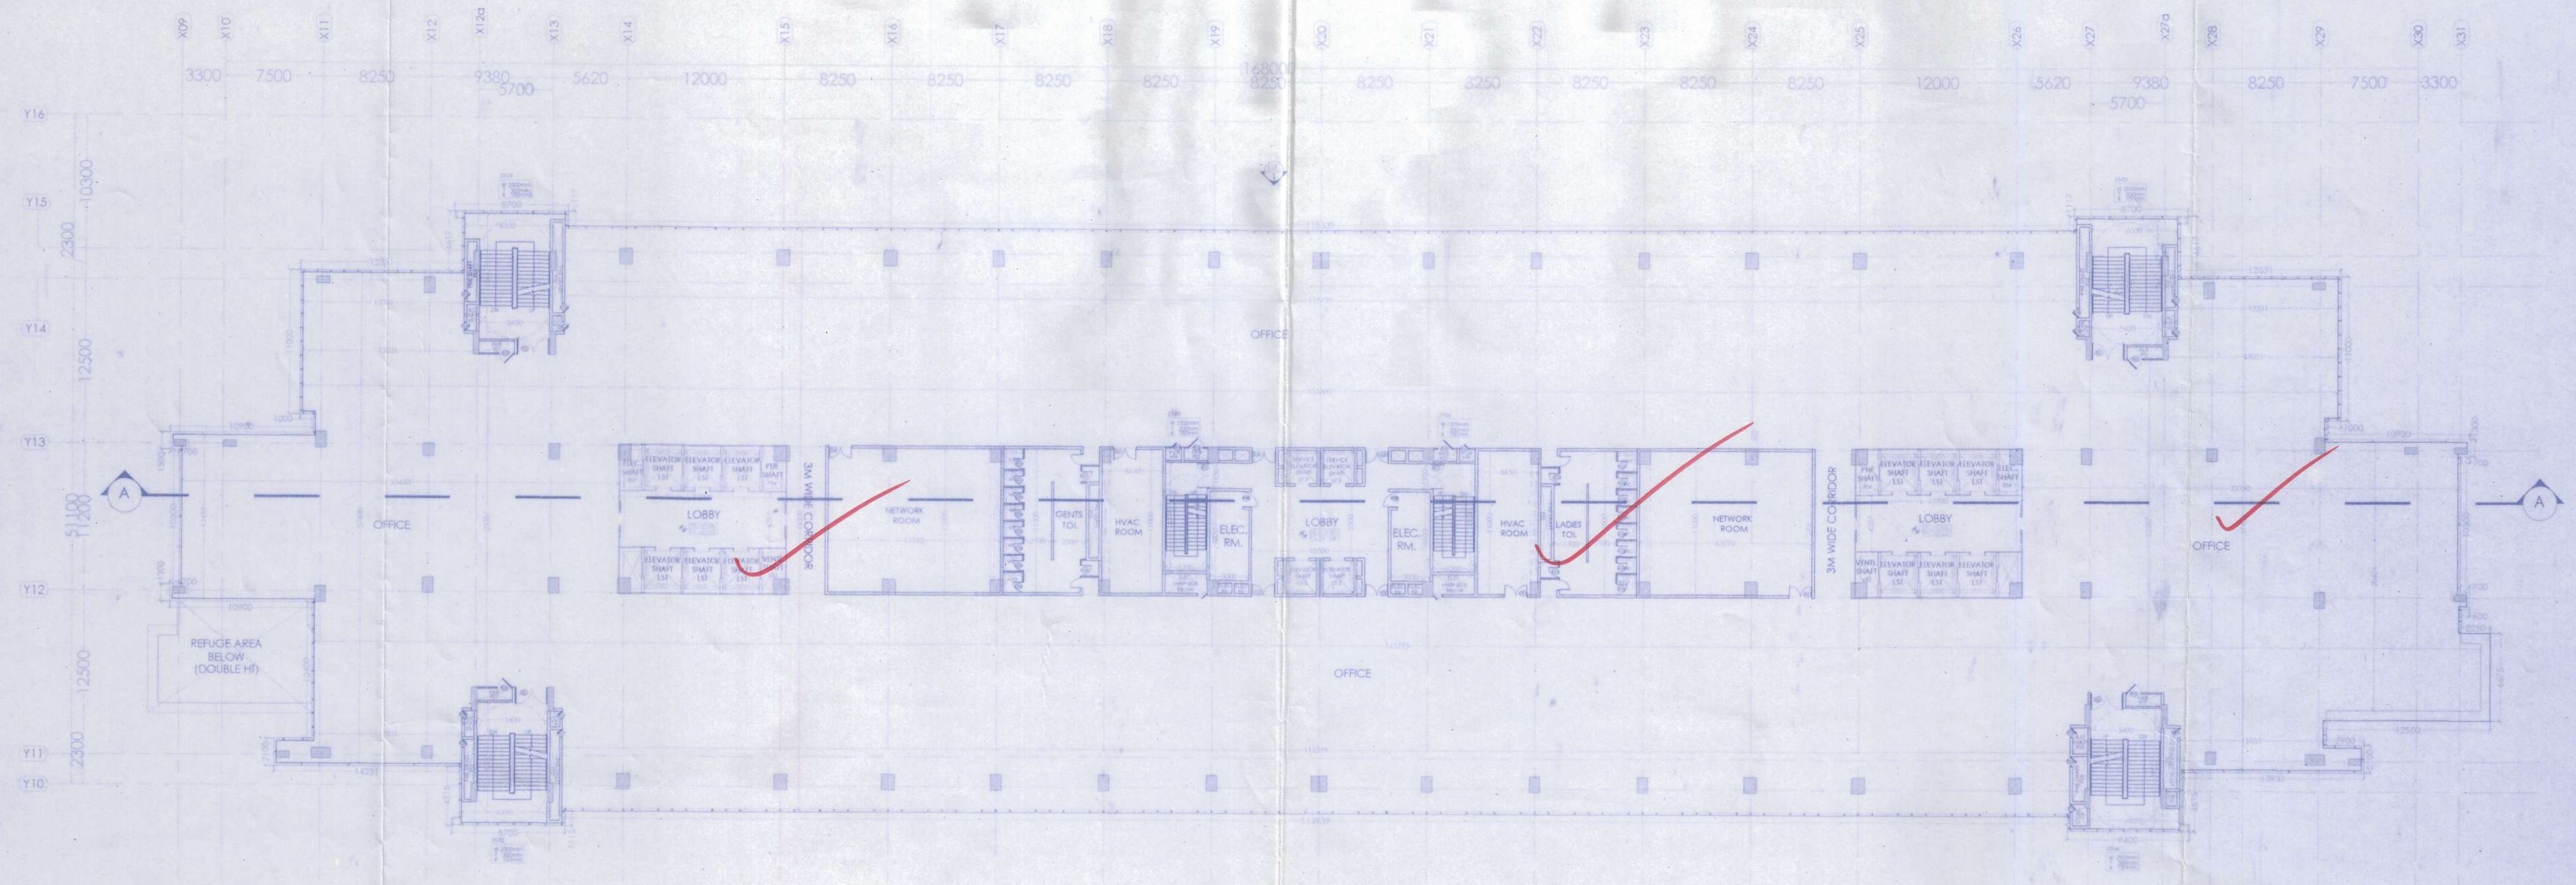

TWELFTH FLOOR PLAN

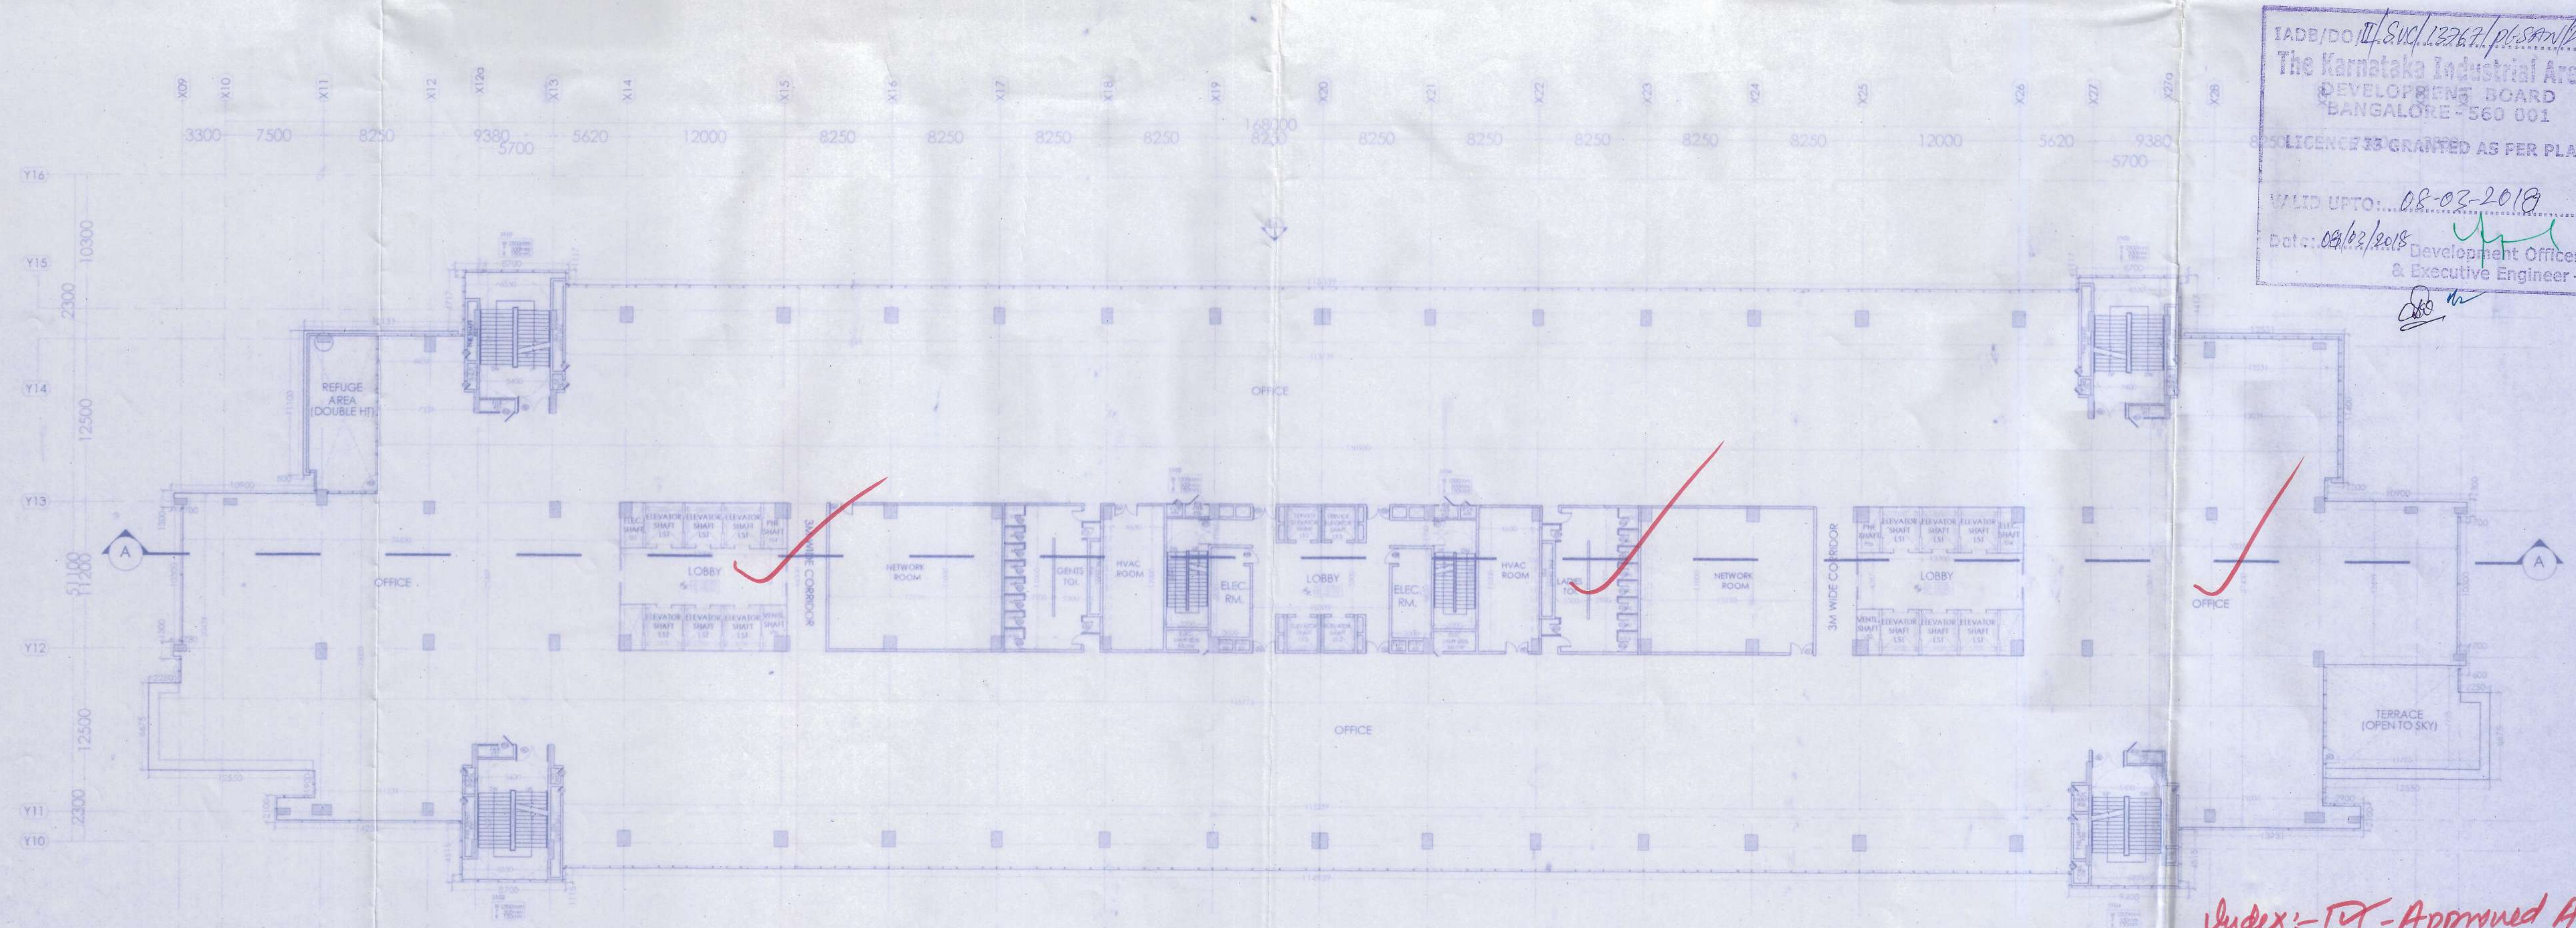

THIRTEENTH FLOOR PLAN

IADB/DO/II/SVC/13767/pG-SAN/2017-18
The Karnataka Industrial Areas
DEVELOPMENT BOARD
BANGALORE - 560 001
LICENCE IS GRANTED AS PER PLAN
VALID UPTO: 08-03-2018
Date: 08/03/2018
Development Officer
& Executive Engineer - II

Index:- ☑ - Approved Area

LOCATION PLAN

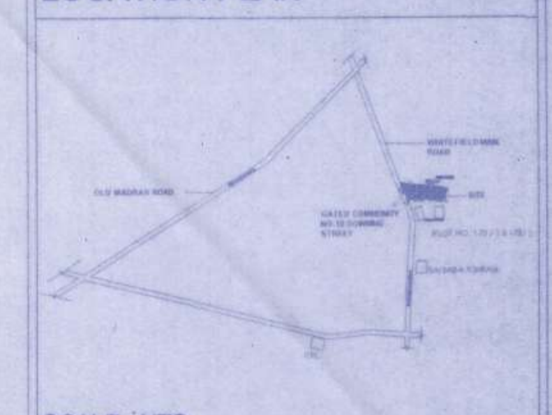

SCALE : NTS

SPECIFIC NOTES

ALL DIMENSIONS ARE IN MILLIMETRES

DETAILS OF RAIN WATER HARVESTING STRUCTURES

(R. W. H)
SECTION OF REFILLED PIT

SECTION OF
PERCOLATION PIT

DOOR WINDOW SCHEDULE

Sl.No.	Name	Sizes	Location
DOORS:			
01	[illegible]	1400 x 2400mm	Entrance - EAST CORE
02	[illegible]	1300 x 2400mm	Entrance - WEST CORE
03	[illegible]	900 x 2400mm	Bedrooms door
04	[illegible]	900 x 2400mm	Utility
05	[illegible]	800 x 2400mm	Toilets
06	[illegible]	800 x 2400mm	Maid room / EWS Toilets
07	[illegible]	800 x 2400mm	EWS
08	[illegible]	800 x 2400mm	Maids Room - WEST CORE
09	[illegible]	900 x 2400mm	Staircase lobby
10	[illegible]	600 x 2400mm	Staircase Lobby
11	[illegible]	1200 x 2400mm	Staircase Lobby
12	[illegible]	1200 x 2400mm	Multipurpose Hall-LVL2
13	[illegible]	1150 x 2400mm	Clubhouse
14	[illegible]	1000 x 2400mm	Toilets- LVL 2
15	[illegible]	800 x 2400mm	Toilets- Clubhouse
16	[illegible]	750 x 2400mm	Toilets- LVL 2
17	[illegible]	3375 x 2400mm	Balcony
18	[illegible]	4575 x 2400mm	Balcony
19	[illegible]	1500 x 2400mm	Balcony
20	[illegible]	2550 x 2400mm	Entrance lobby
21	[illegible]	2300 x 2400mm	Clubhouse
22	[illegible]	2000 x 2400mm	Terraces
23	[illegible]	2550 x 2400mm	Entrance Lobby
24	[illegible]	1200 x 2400mm	Staircase Lobby
25	[illegible]	800 x 2400mm	Steam / Sauna - Clubhouse
WINDOWS:			
26	[illegible]	1800 x 2100mm	Bedroom
27	[illegible]	1700 x 2100mm	Bedroom
28	[illegible]	1500 x 2100mm	Kitchen
29	[illegible]	900 x 2100mm	Toilets
30	[illegible]	900 x 2100mm	EWS /EWS Toilet / OTS
31	[illegible]	1200 x 2100mm	Staircase Lobby
32	[illegible]	16800 x 3500mm	Living Room
33	[illegible]	14820x 3500mm	Living Room
34	[illegible]	10240x 3500mm	Living Room
35	[illegible]	8400x 3500mm	Bedroom
36	[illegible]	8400x 3500mm	Ventilation shaft / Dining rm

MRUTHYUNJAYA
EMP No. KIADB/Engr/006/2017-18

PROJECT :

"WHITEFIELD TOWERS"
PROPOSED BUILDING (BONSAI) FOR
M/S AUBERGINE PROPERTIES PVT LTD.
ON SY NO 173/1 & 173/2 OF
KANNAMANGALA VILLAGE ,
BIDHARA HALLI HOBLI,
BANGALORE EAST TALUK,
BANGALORE -560067

OWNER'S SIGNATURE

For Aubergine Properties Pvt. Ltd.

Authorised Signatory

ARCHITECT'S SIGNATURE

Antony Kunnel George
COA Regn. No. CA/9[illegible]
BCC Regn. No. BCC/BL-3[illegible]

SUBJECT OF THE DRAWING :

TWELFTH FLOOR PLAN
THIRTEENTH FLOOR PLAN

SHEET NO :	7 OF 10
SCALE :	1:300
DATE :	18.02.2011

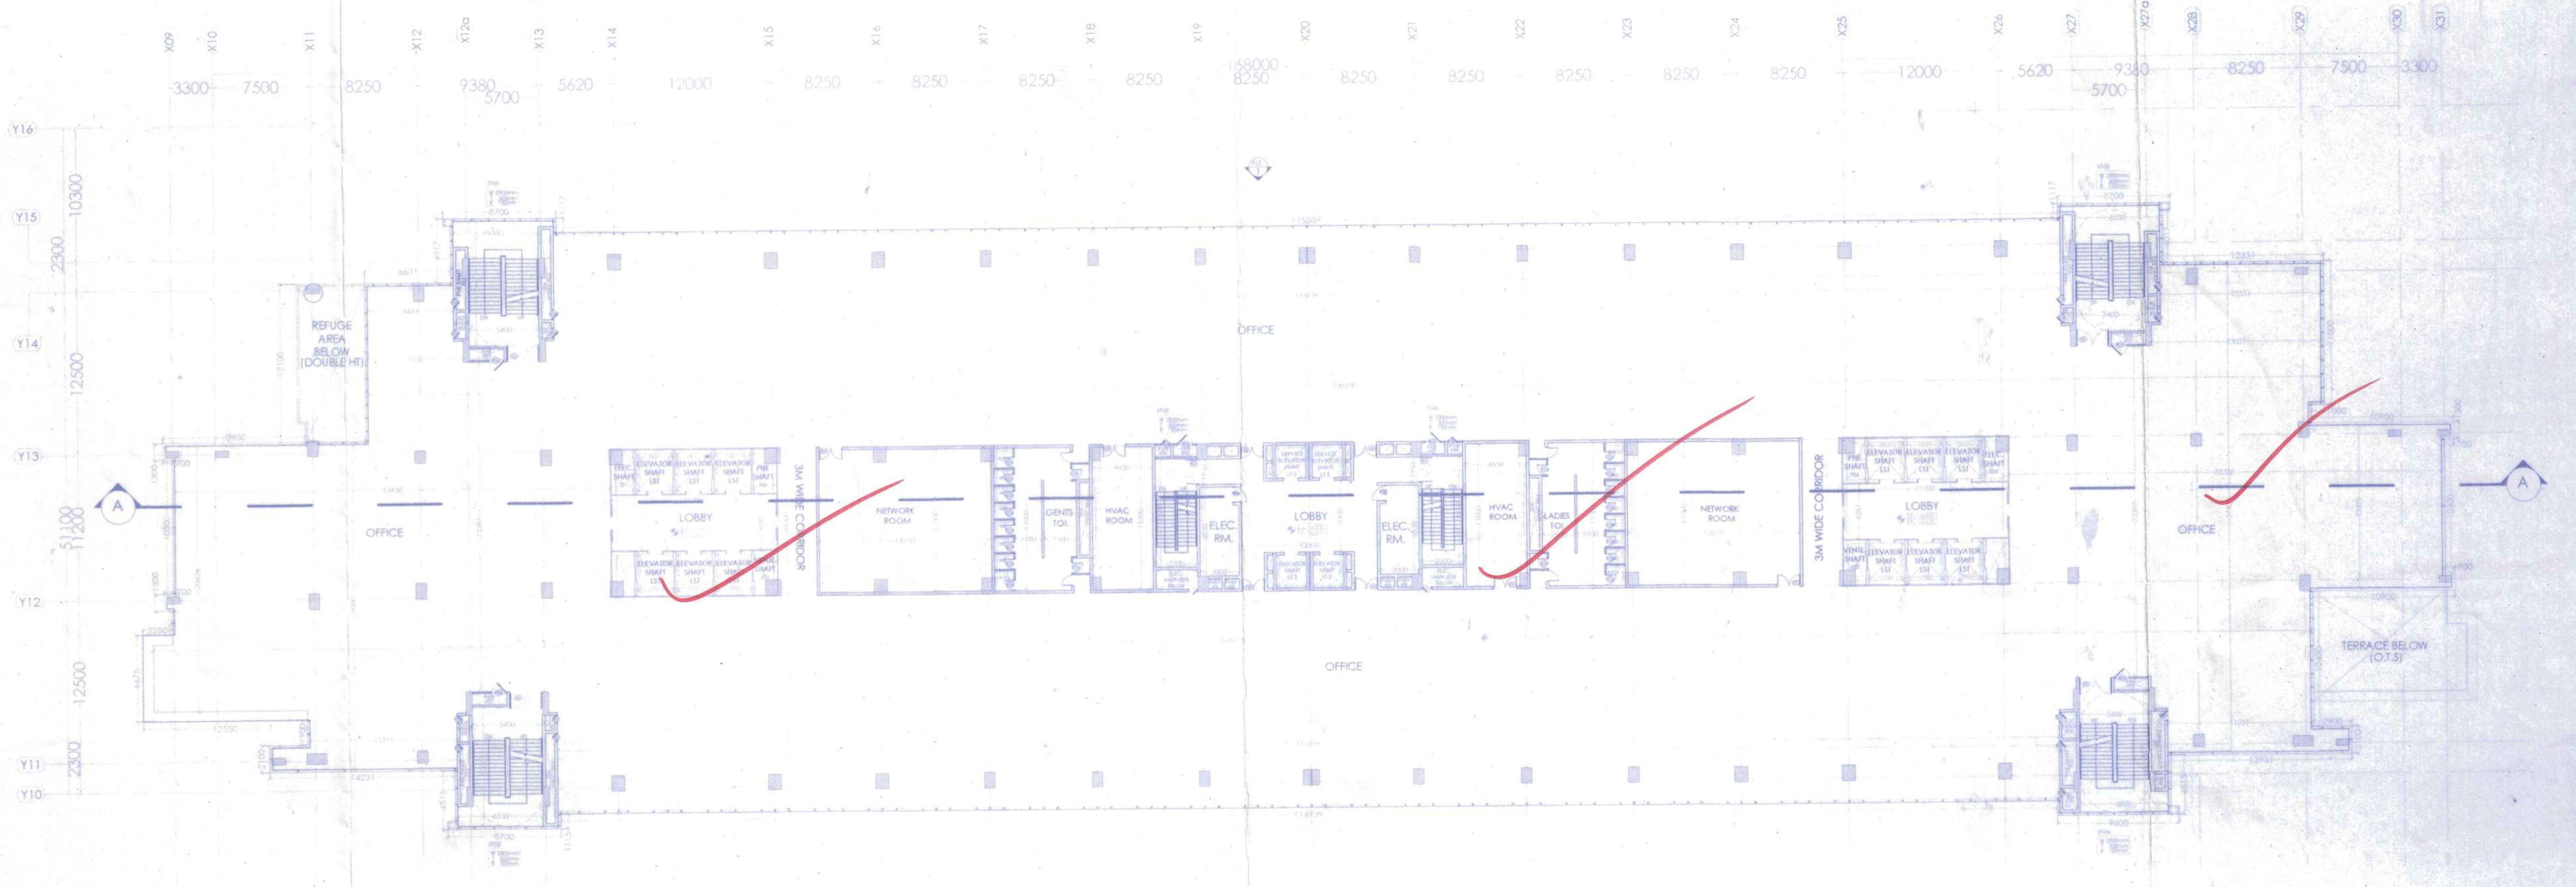

FOURTEENTH FLOOR PLAN

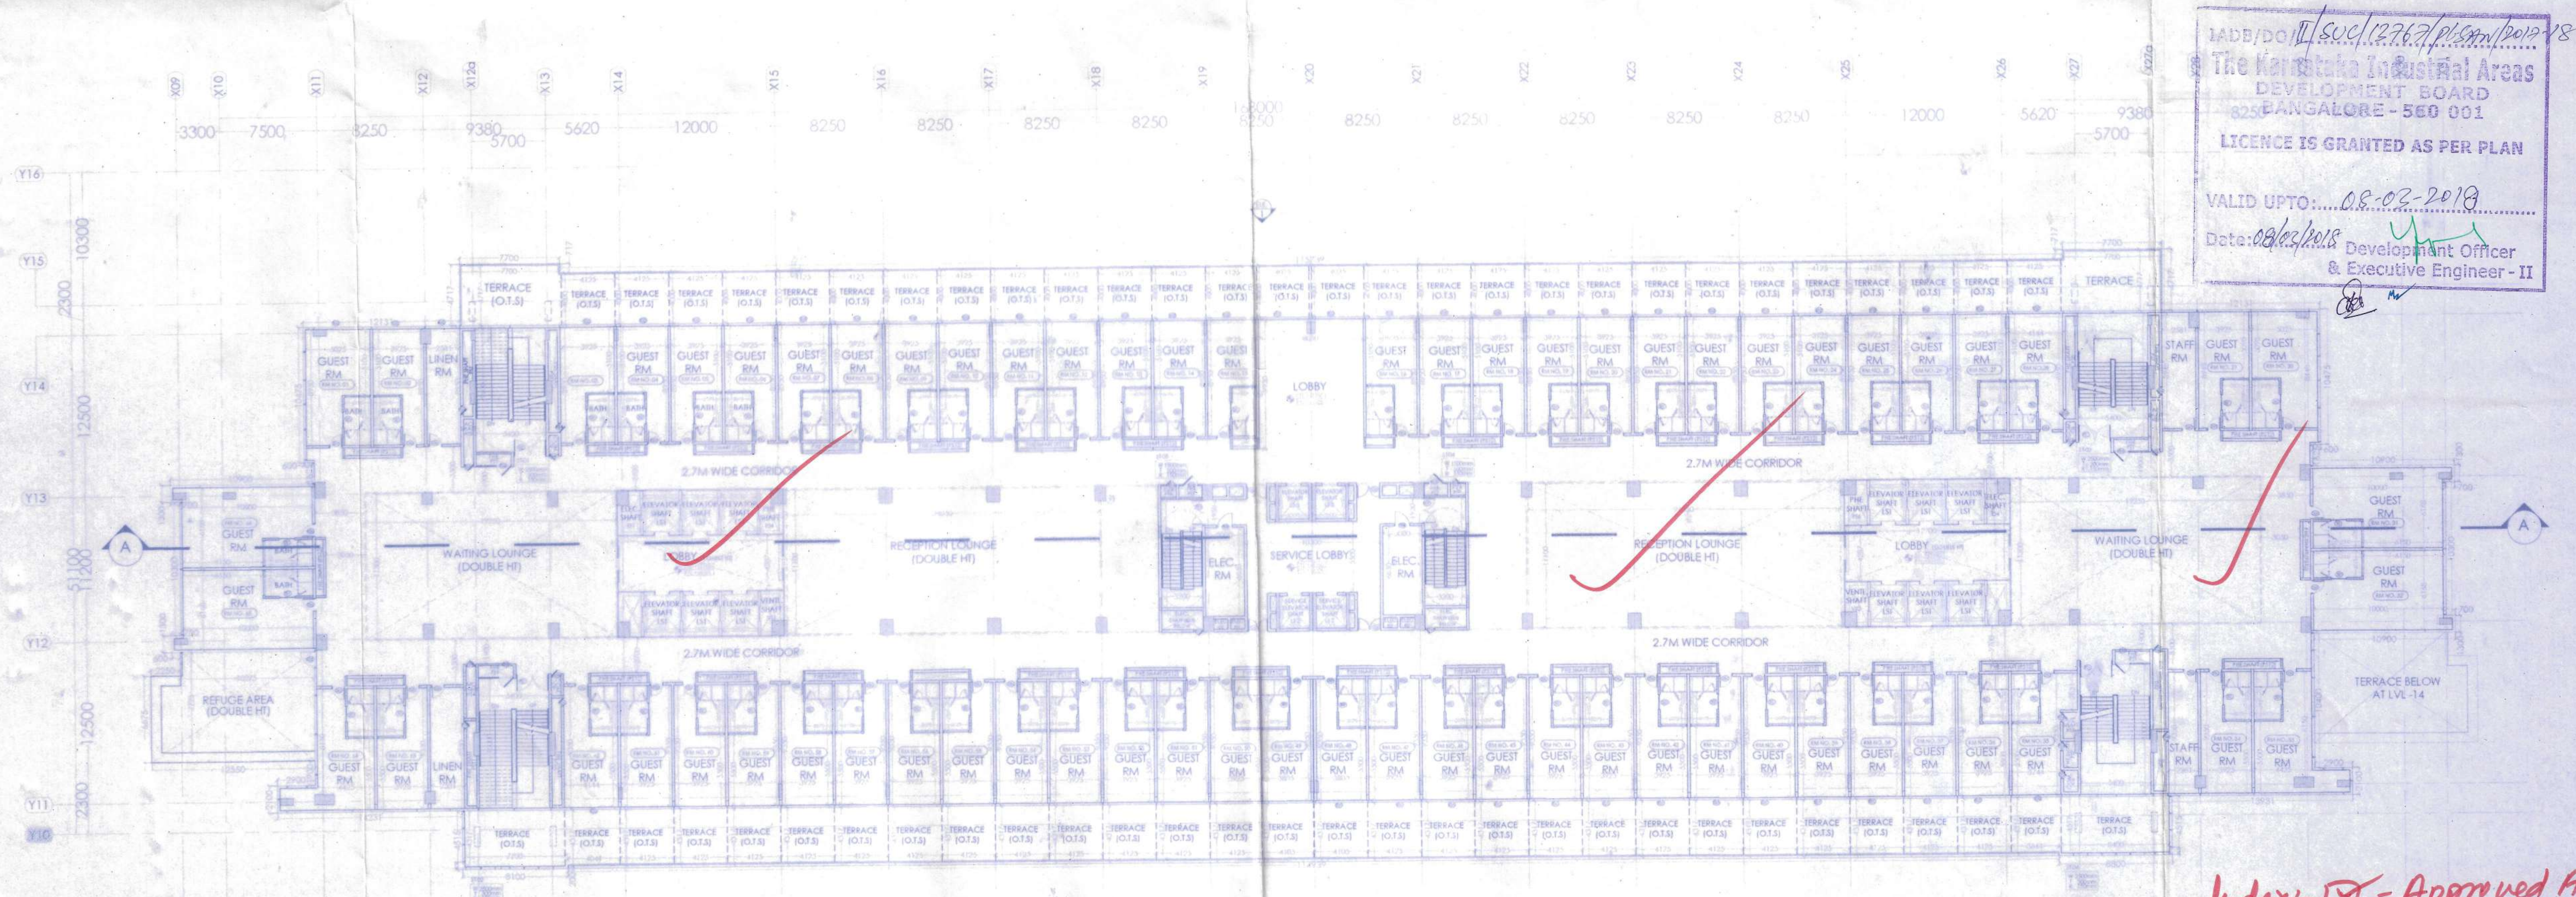

FIFTEENTH FLOOR PLAN

IADB/DO/II/SUC/13767/plsan/2017-18
The Karnataka Industrial Areas
DEVELOPMENT BOARD
BANGALORE - 560 001
LICENCE IS GRANTED AS PER PLAN
VALID UPTO: 08-03-2018
Date: 08/03/2018 Development Officer
& Executive Engineer - II

Index:- ☑ - Approved Area

LOCATION PLAN

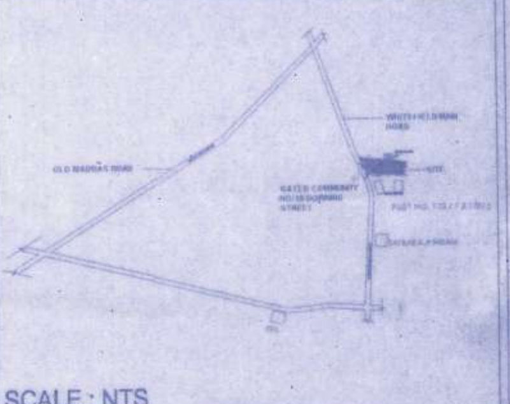

SCALE : NTS

SPECIFIC NOTES

ALL DIMENSIONS ARE IN MILLIMETRES

DETAILS OF RAIN WATER HARVESTING STRUCTURES

(R. W. H)
SECTION OF REFILLED PIT

SECTION OF PERCOLATION PIT

DOOR WINDOW SCHEDULE

Sl.No.	Name	Sizes	Location
DOORS:			
01	[illegible]	1400 x 2400mm	Entrance - EAST CORE
02	[illegible]	1300 x 2400mm	Entrance - WEST CORE
03	[illegible]	900 x 2400mm	Bedrooms door
04	[illegible]	900 x 2400mm	utility
05	[illegible]	800 x 2400mm	Toilets
06	[illegible]	800 x 2400mm	Maid room / EWS Toilets
07	[illegible]	800 x 2400mm	EWS
08	[illegible]	800 x 2400mm	Maids Rooms - WEST CORE
09	[illegible]	900 x 2400mm	Staircase Lobby
10	[illegible]	600 x 2400mm	Staircase Lobby
11	[illegible]	1200 x 2400mm	Staircase Lobby
12	[illegible]	1200 x 2400mm	Multipurpose Hall-Lvl2
13	[illegible]	1150 x 2400mm	Clubhouse
14	[illegible]	1000 x 2400mm	Toilets- Lvl 2
15	[illegible]	800 x 2400mm	Toilets- Clubhouse
16	[illegible]	750 x 2400mm	Toilets- Lvl 2
17	[illegible]	3375 x 2400mm	Balcony
18	[illegible]	4575 x 2400mm	Balcony
19	[illegible]	1500 x 2400mm	Balcony
20	[illegible]	2550 x 2400mm	Enterance lobby
21	[illegible]	2300 x 2400mm	Clubhouse
22	[illegible]	2000 x 2400mm	Teraces
23	[illegible]	2550 x 2400mm	Enterance Lobby
24	[illegible]	1200 x 2400mm	Staircase Lobby
25	[illegible]	800 x 2400mm	Steam / Sauna - Clubhouse
WINDOWS:			
26	[illegible]	1800 x 2100mm	Bedroom
27	[illegible]	1700 x 2100mm	Bedroom
28	[illegible]	1500 x 2100mm	Kitchen
29	[illegible]	900 x 2100mm	Toilets
30	[illegible]	900 x 2100mm	EWS /EWS Toilet / OTS
31	[illegible]	1200 x 2100mm	Staircase Lobby
32	[illegible]	16800 x 3500mm	Living Room
33	[illegible]	14820x 3500mm	Living Room
34	[illegible]	10240x 3500mm	Living Room
35	[illegible]	8400x 3500mm	Bedroom
36	[illegible]	8400x 3500mm	Ventilation shaft / Dining rm

MRUTHYUNJAYA
EMP No. KIADB/Engr/006/2017-18

PROJECT :

"WHITEFIELD TOWERS"
PROPOSED BUILDING (BONSAI) FOR
M/S AUBERGINE PROPERTIES PVT LTD.
ON SY NO 173/1 & 173/2 OF
KANNAMANGALA VILLAGE ,
BIDHARA HALLI HOBLI,
BANGALORE EAST TALUK,
BANGALORE -560067

OWNER'S SIGNATURE

For Aubergine Properties Pvt. Ltd.

Authorised Signatory

ARCHITECT'S SIGNATURE

Antony Kunnel George
COA Regn. No. CA/98/22820
BCC Regn. No. BCC/BL-3.2.3/A-815/98

SUBJECT OF THE DRAWING :

FOURTEENTH FLOOR PLAN
FIFTEENTH FLOOR PLAN

SHEET NO :	8 OF 10
SCALE :	1:300
DATE :	18.02.2011

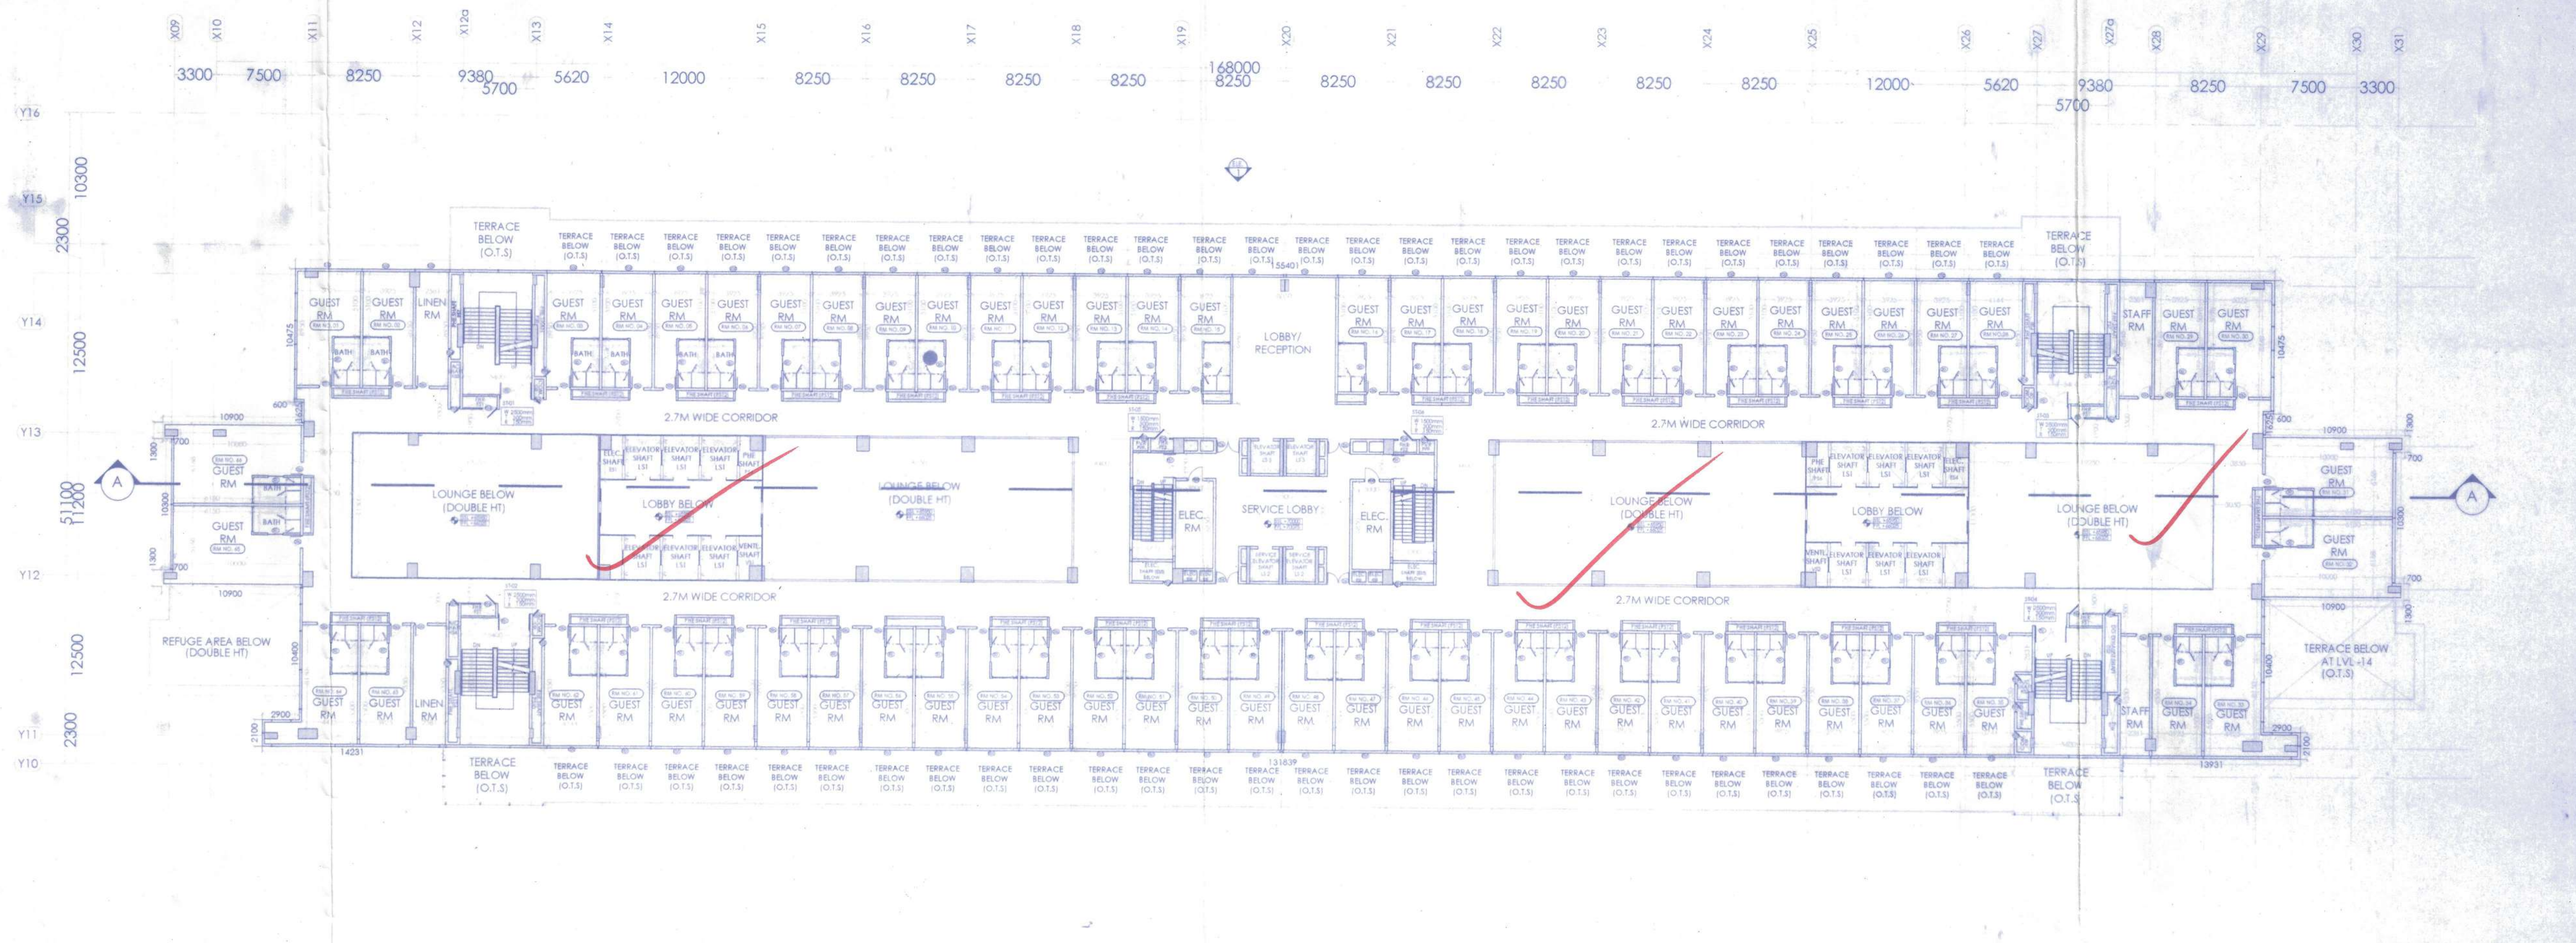

SIXTEENTH FLOOR PLAN

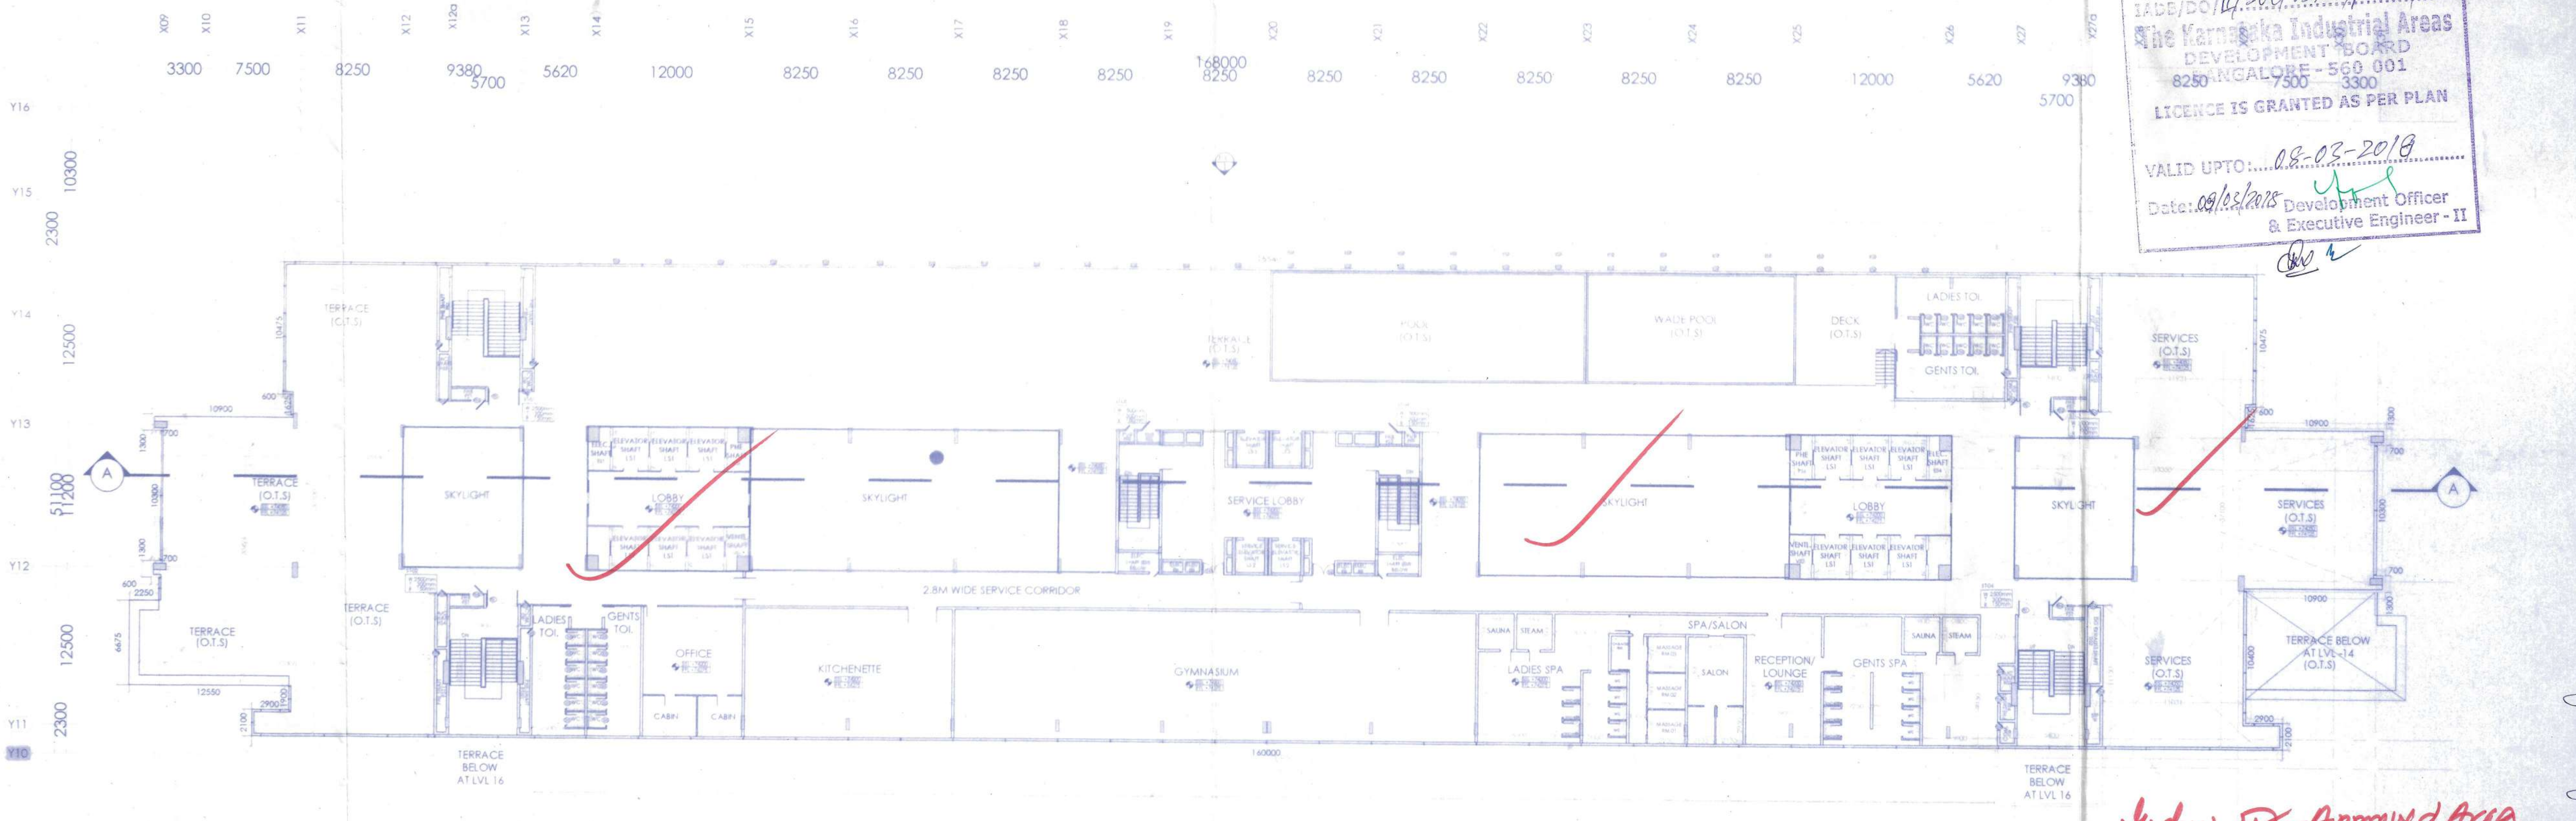

Index IV - Approved Area

SEVENTEENTH FLOOR PLAN

IADB/DO/IV/SUC/13767/P(-SAN/2017-18
The Karnataka Industrial Areas
DEVELOPMENT BOARD
BANGALORE - 560 001
LICENCE IS GRANTED AS PER PLAN
VALID UPTO: 08-03-2019
Date: 09/03/2018 Development Officer
& Executive Engineer - II

LOCATION PLAN

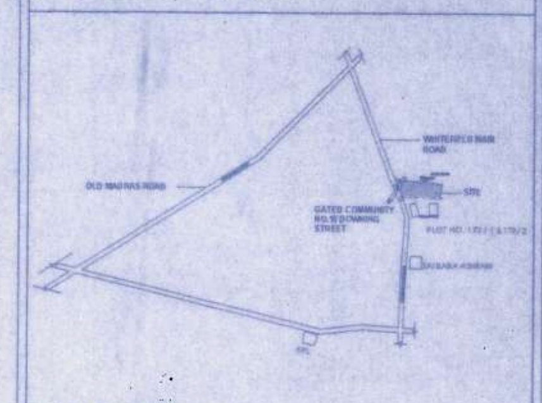

SCALE : NTS

SPECIFIC NOTES

ALL DIMENSIONS ARE IN MILLIMETRES

DETAILS OF RAIN WATER HARVESTING STRUCTURES

(R.W.H)
SECTION OF REFILLED PIT

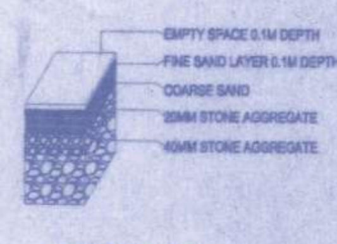

SECTION OF PERCOLATION PIT

DOOR WINDOW SCHEDULE

SL.No.	Name	Sizes	Location
DOORS:			
01	[illegible]	1400 x 2400mm	Entrance - EAST CORE
02	[illegible]	1300 x 2400mm	Entrance - WEST CORE
03	[illegible]	900 x 2400mm	Bedrooms door
04	[illegible]	900 x 2400mm	Utility
05	[illegible]	800 x 2400mm	Toilets
06	[illegible]	800 x 2400mm	Maid room / EWS Toilets
07	[illegible]	800 x 2400mm	EWS
08	[illegible]	800 x 2400mm	Maids Room - WEST CORE
09	[illegible]	900 x 2400mm	Staircase Lobby
10	[illegible]	600 x 2400mm	Staircase Lobby
11	[illegible]	1200 x 2400mm	Staircase Lobby
12	[illegible]	1200 x 2400mm	Multipurpose Hall-LVL2
13	[illegible]	1150 x 2400mm	Clubhouse
14	[illegible]	1000 x 2400mm	Toilets- LVL 2
15	[illegible]	800 x 2400mm	Toilets- Clubhouse
16	[illegible]	750 x 2400mm	Toilets- LVL 2
17	[illegible]	3375 x 2400mm	Balcony
18	[illegible]	4575 x 2400mm	Balcony
19	[illegible]	1500 x 2400mm	Balcony
20	[illegible]	2550 x 2400mm	Enterance lobby
21	[illegible]	2300 x 2400mm	Clubhouse
22	[illegible]	2000 x 2400mm	Terraces
23	[illegible]	2550 x 2400mm	Enterance Lobby
24	[illegible]	1200 x 2400mm	Staircase Lobby
25	[illegible]	800 x 2400mm	Steam / Sauna - Clubhouse
WINDOWS:			
26	[illegible]	1800 x 2100mm	Bedroom
27	[illegible]	1700 x 2100mm	Bedroom
28	[illegible]	1500 x 2100mm	Kitchen
29	[illegible]	900 x 2100mm	Toilets
30	[illegible]	900 x 2100mm	EWS /EWS Toilet / OTS
31	[illegible]	1200 x 2100mm	Staircase Lobby
32	[illegible]	16800 x 3500mm	Living Room
33	[illegible]	14820x 3500mm	Living Room
34	[illegible]	10240x 3500mm	Living Room
35	[illegible]	8400x 3500mm	Bedroom
36	[illegible]	8400x 3500mm	Ventilation shaft / Dining.rm

MRUTHYUNJAYA
EMP No. KIADB/Engr/006/2017-18

PROJECT :

"WHITEFIELD TOWERS"
PROPOSED BUILDING (BONSAI) FOR
M/S AUBERGINE PROPERTIES PVT LTD.
ON SY NO 173/1 & 173/2 OF
KANNAMANGALA VILLAGE ,
BIDHARA HALLI HOBLI,
BANGALORE EAST TALUK,
BANGALORE -560067

OWNER'S SIGNATURE

For Aubergine Properties Pvt. Ltd.
Authorised Signatory

ARCHITECT'S SIGNATURE

Antony Kunnel George
COA Regn. No. CA/98/22820
BCC Regn. No. BCC/BL 3.2.3/A-815/98-99

SUBJECT OF THE DRAWING :

SIXTEENTH FLOOR PLAN
SEVENTEENTH FLOOR PLAN

SHEET NO :	9 OF 10
SCALE :	1:300
DATE :	18.02.2011

As Built Floor Plan

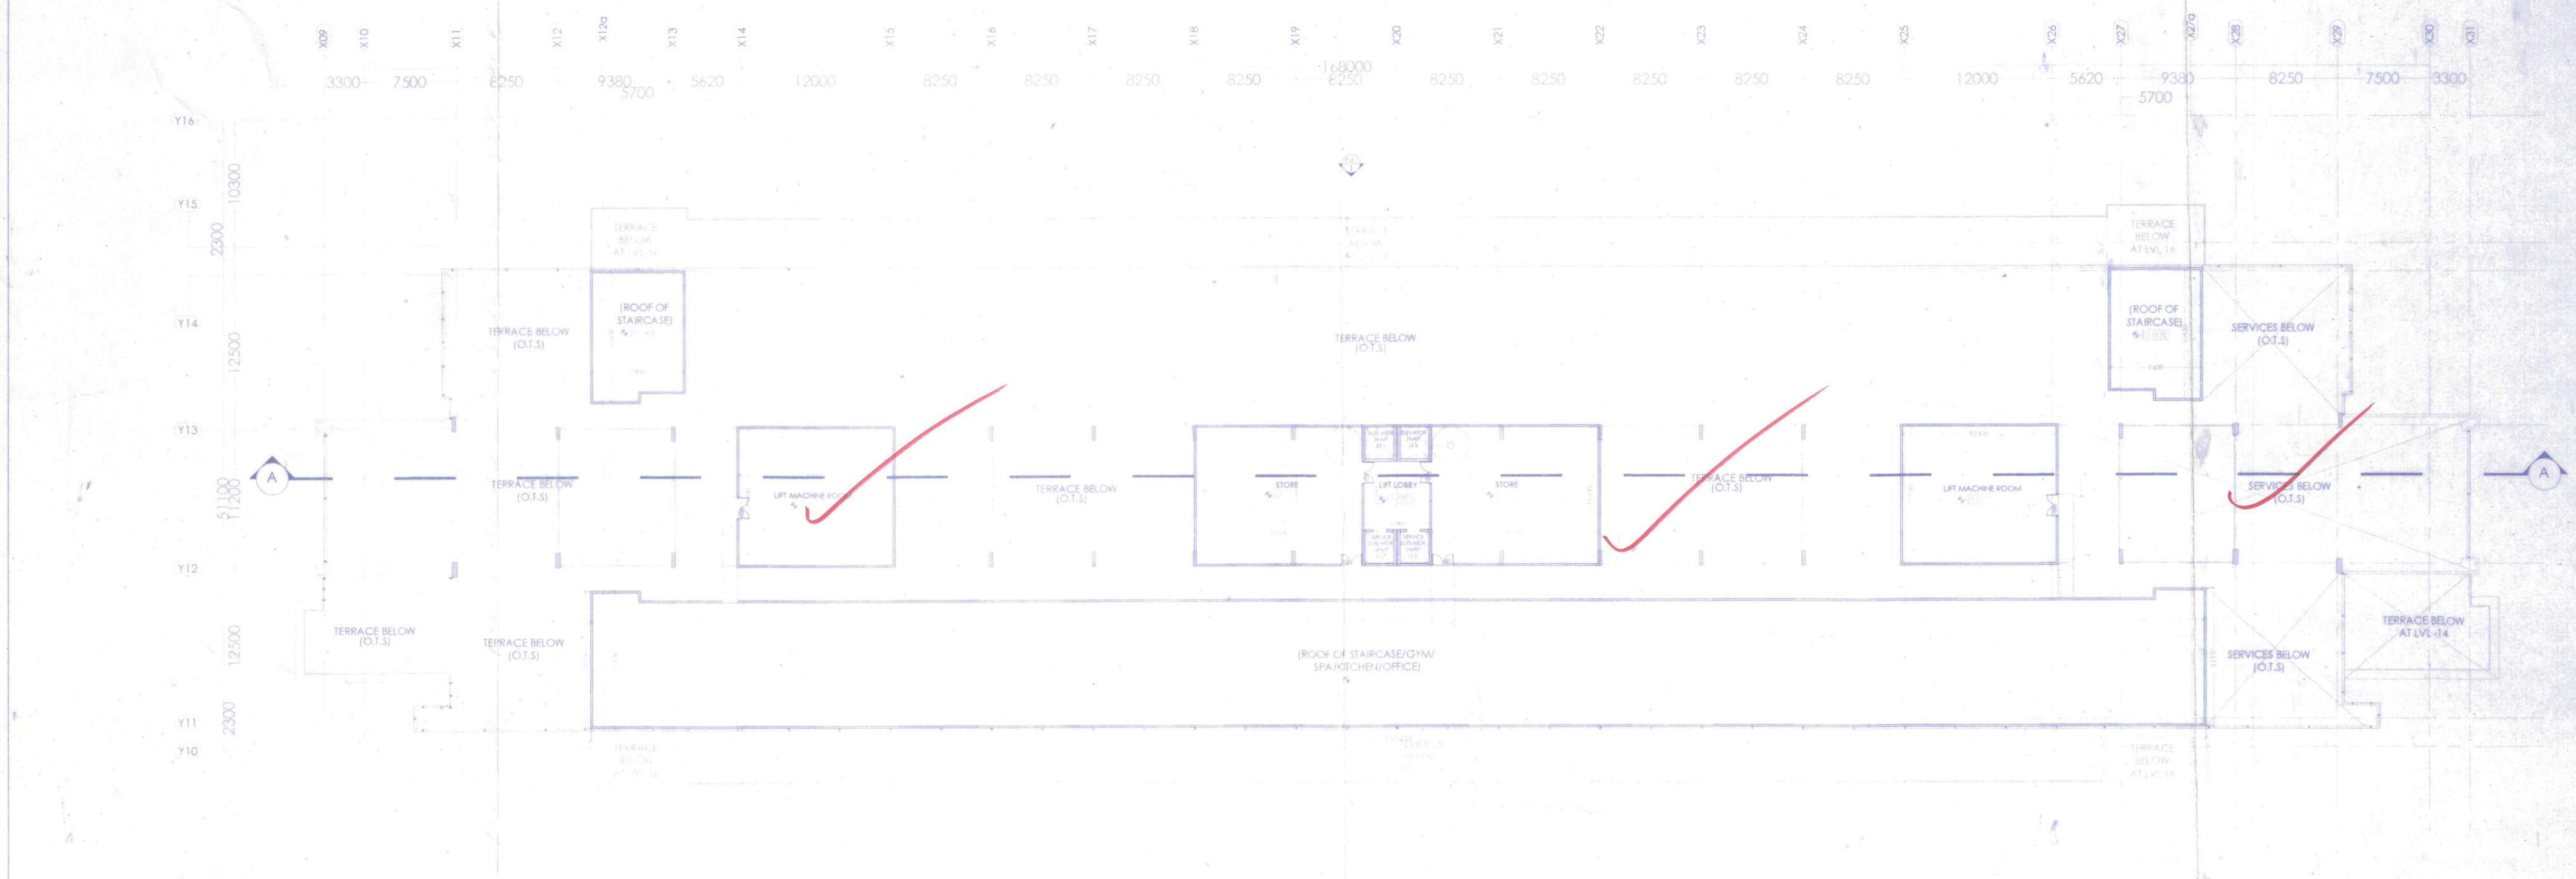

EIGHTEENTH FLOOR PLAN

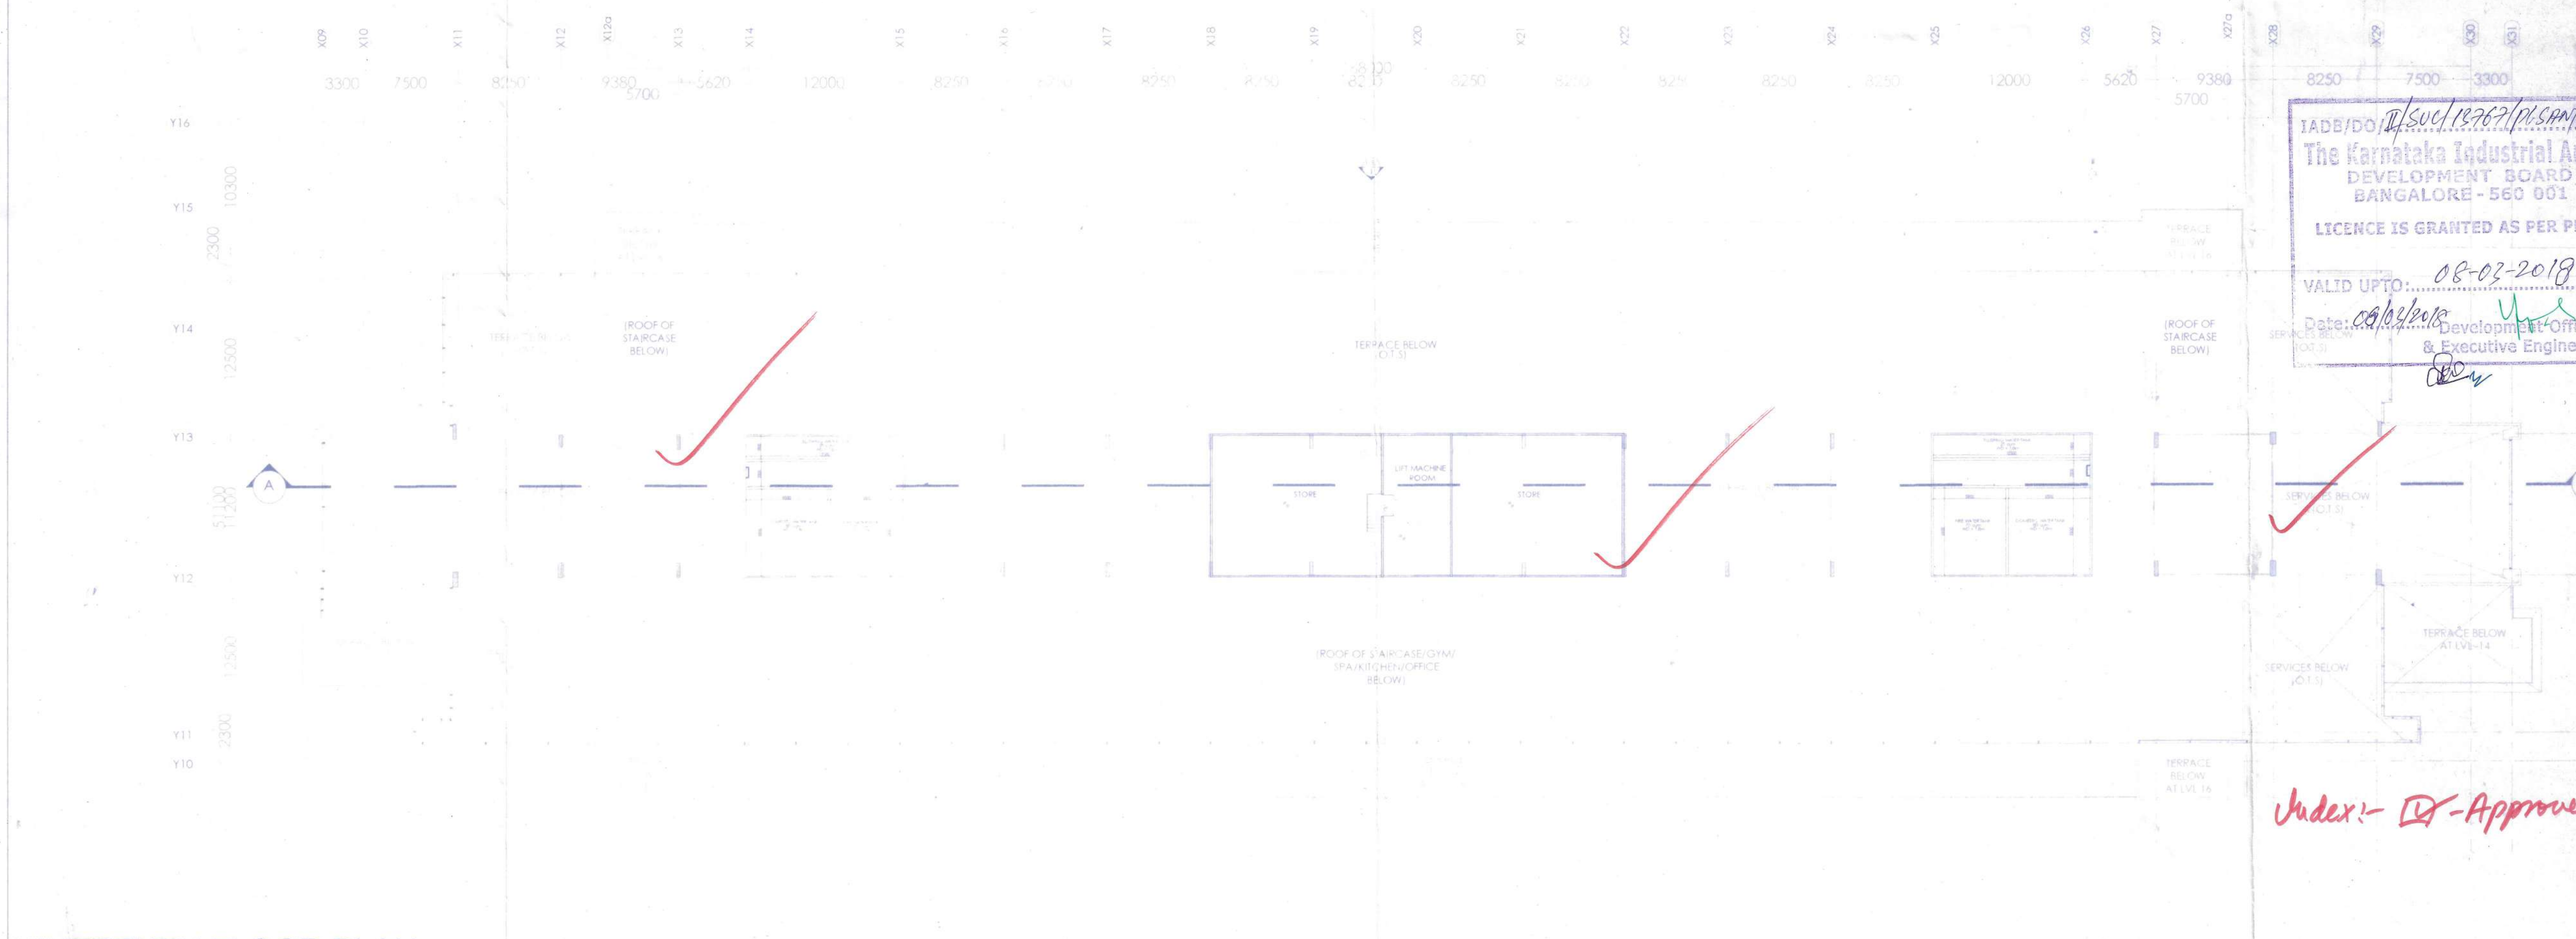

IADB/DO/II/SUC/13767/PLSAN/2017-18
The Karnataka Industrial Areas
DEVELOPMENT BOARD
BANGALORE - 560 001
LICENCE IS GRANTED AS PER PLAN
VALID UPTO: 08-03-2018
Date: 08/03/2018 Development Officer
& Executive Engineer - II

Index:- ☐ - Approved Area.

NINTEENTH FLOOR PLAN

LOCATION PLAN

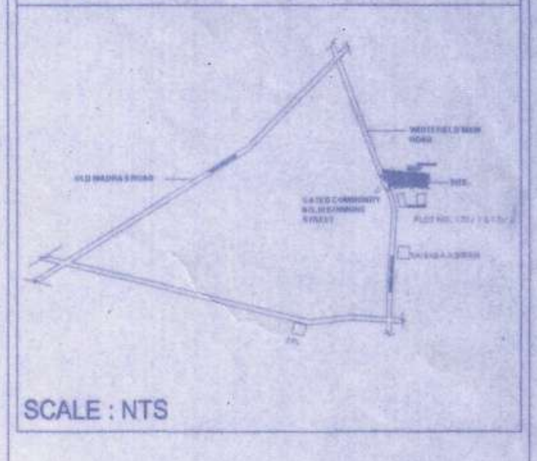

SCALE : NTS

SPECIFIC NOTES

ALL DIMENSIONS ARE IN MILLIMETRES

DETAILS OF RAIN WATER HARVESTING STRUCTURES

(R. W. H)
SECTION OF REFILLED PIT

SECTION OF PERCOLATION PIT

DOOR WINDOW SCHEDULE

SL.No.	Name	Sizes	Location
DOORS:			
01	[illegible]	1400 x 2400mm	Entrance - EAST CORE
02	[illegible]	1300 x 2400mm	Entrance - WEST CORE
03	[illegible]	900 x 2400mm	Bedrooms door
04	[illegible]	900 x 2400mm	Utility
05	[illegible]	800 x 2400mm	Toilets
06	[illegible]	800 x 2400mm	Maid room / EWS Toilets
07	[illegible]	800 x 2400mm	EWS
08	[illegible]	800 x 2400mm	Maids Room - WEST CORE
09	[illegible]	900 x 2400mm	Staircase Lobby
10	[illegible]	600 x 2400mm	Staircase Lobby
11	[illegible]	1200 x 2400mm	Staircase Lobby
12	[illegible]	1200 x 2400mm	Multipurpose Hall-LvL2
13	[illegible]	1150 x 2400mm	Clubhouse
14	[illegible]	1000 x 2400mm	Toilets- LvL 2
15	[illegible]	800 x 2400mm	Toilets- Clubhouse
16	[illegible]	750 x 2400mm	Toilets- LvL 2
17	[illegible]	3375 x 2400mm	Balcony
18	[illegible]	4575 x 2400mm	Balcony
19	[illegible]	1500 x 2400mm	Balcony
20	[illegible]	2550 x 2400mm	Enterance lobby
21	[illegible]	2300 x 2400mm	Clubhouse
22	[illegible]	2000 x 2400mm	Terraces
23	[illegible]	2550 x 2400mm	Enterance Lobby
24	[illegible]	1200 x 2400mm	Staircase Lobby
25	[illegible]	800 x 2400mm	Steam / Sauna - Clubhouse
WINDOWS:			
26	[illegible]	1800 x 2100mm	Bedroom
27	[illegible]	1700 x 2100mm	Bedroom
28	[illegible]	1500 x 2100mm	Kitchen
29	[illegible]	900 x 2100mm	Toilets
30	[illegible]	900 x 2100mm	EWS /EWS Toilet / OTS
31	[illegible]	1200 x 2100mm	Staircase lobby
32	[illegible]	16800 x 3500mm	Living Room
33	[illegible]	14820x 3500mm	Living Room
34	[illegible]	10240x 3500mm	Living Room
35	[illegible]	8400x 3500mm	Bedroom
36	[illegible]	8400x 3500mm	Ventilation shaft / Dining rm

MRUTHYUNJAYA
EMP No. KIADB/Engr/006/2017-18

PROJECT :

"WHITEFIELD TOWERS"
PROPOSED BUILDING (BONSAI) FOR
M/S AUBERGINE PROPERTIES PVT LTD.
ON SY NO 173/1 & 173/2 OF
KANNAMANGALA VILLAGE ,
BIDHARA HALLI HOBLI,
BANGALORE EAST TALUK,
BANGALORE -560067

OWNER'S SIGNATURE

For Aubergine Properties Pvt. Ltd.

Authorised Signatory

ARCHITECT'S SIGNATURE

Antony Kunnel George
COA Regn. No. CA/98/22820
BCC Regn. No. BCC/BL-3.2.3/A-815/98-99

SUBJECT OF THE DRAWING :

EIGHTEENTH FLOOR PLAN
NINTEENTH FLOOR PLAN

SHEET NO :	10 OF 10
SCALE :	1:300
DATE :	18.02.2011

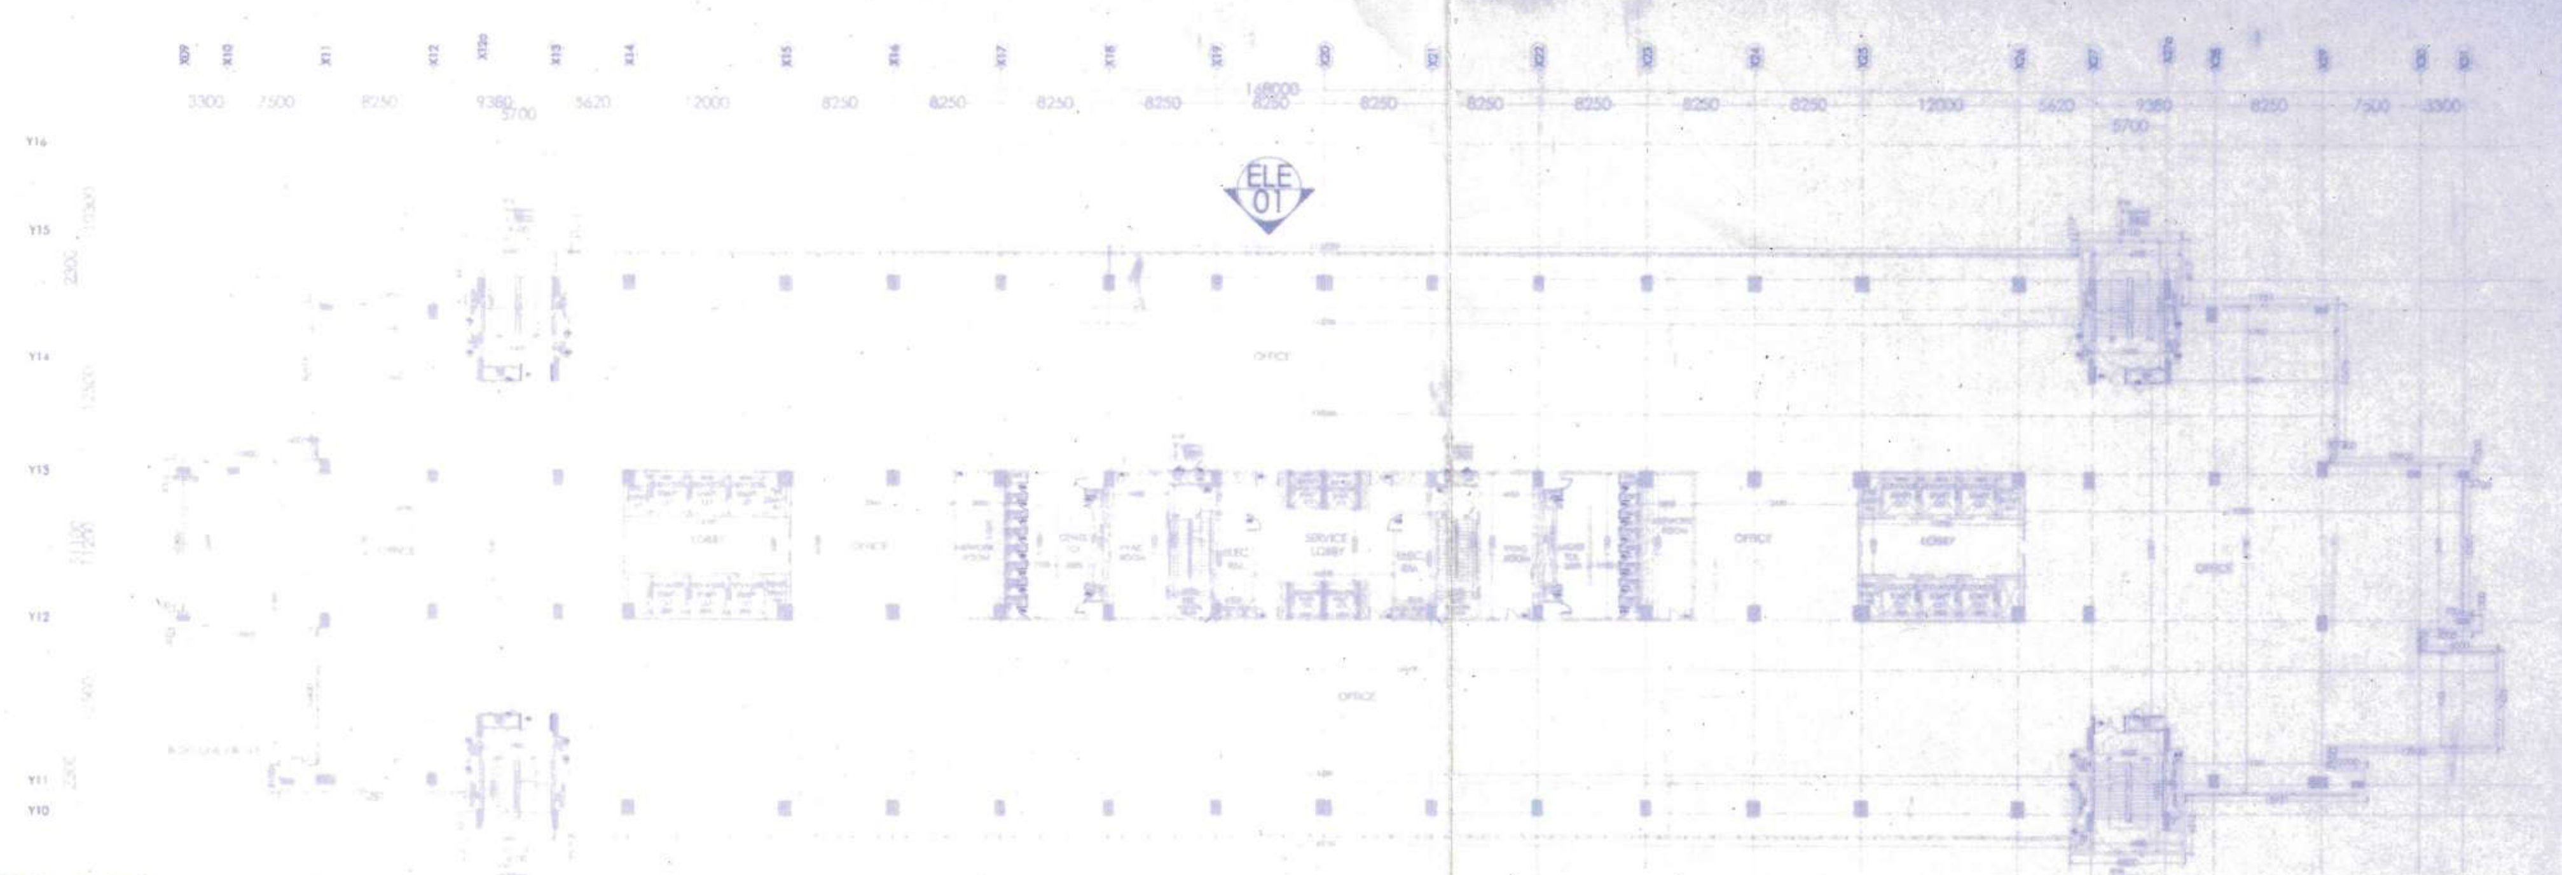

KEY PLAN
SCALE : NTS

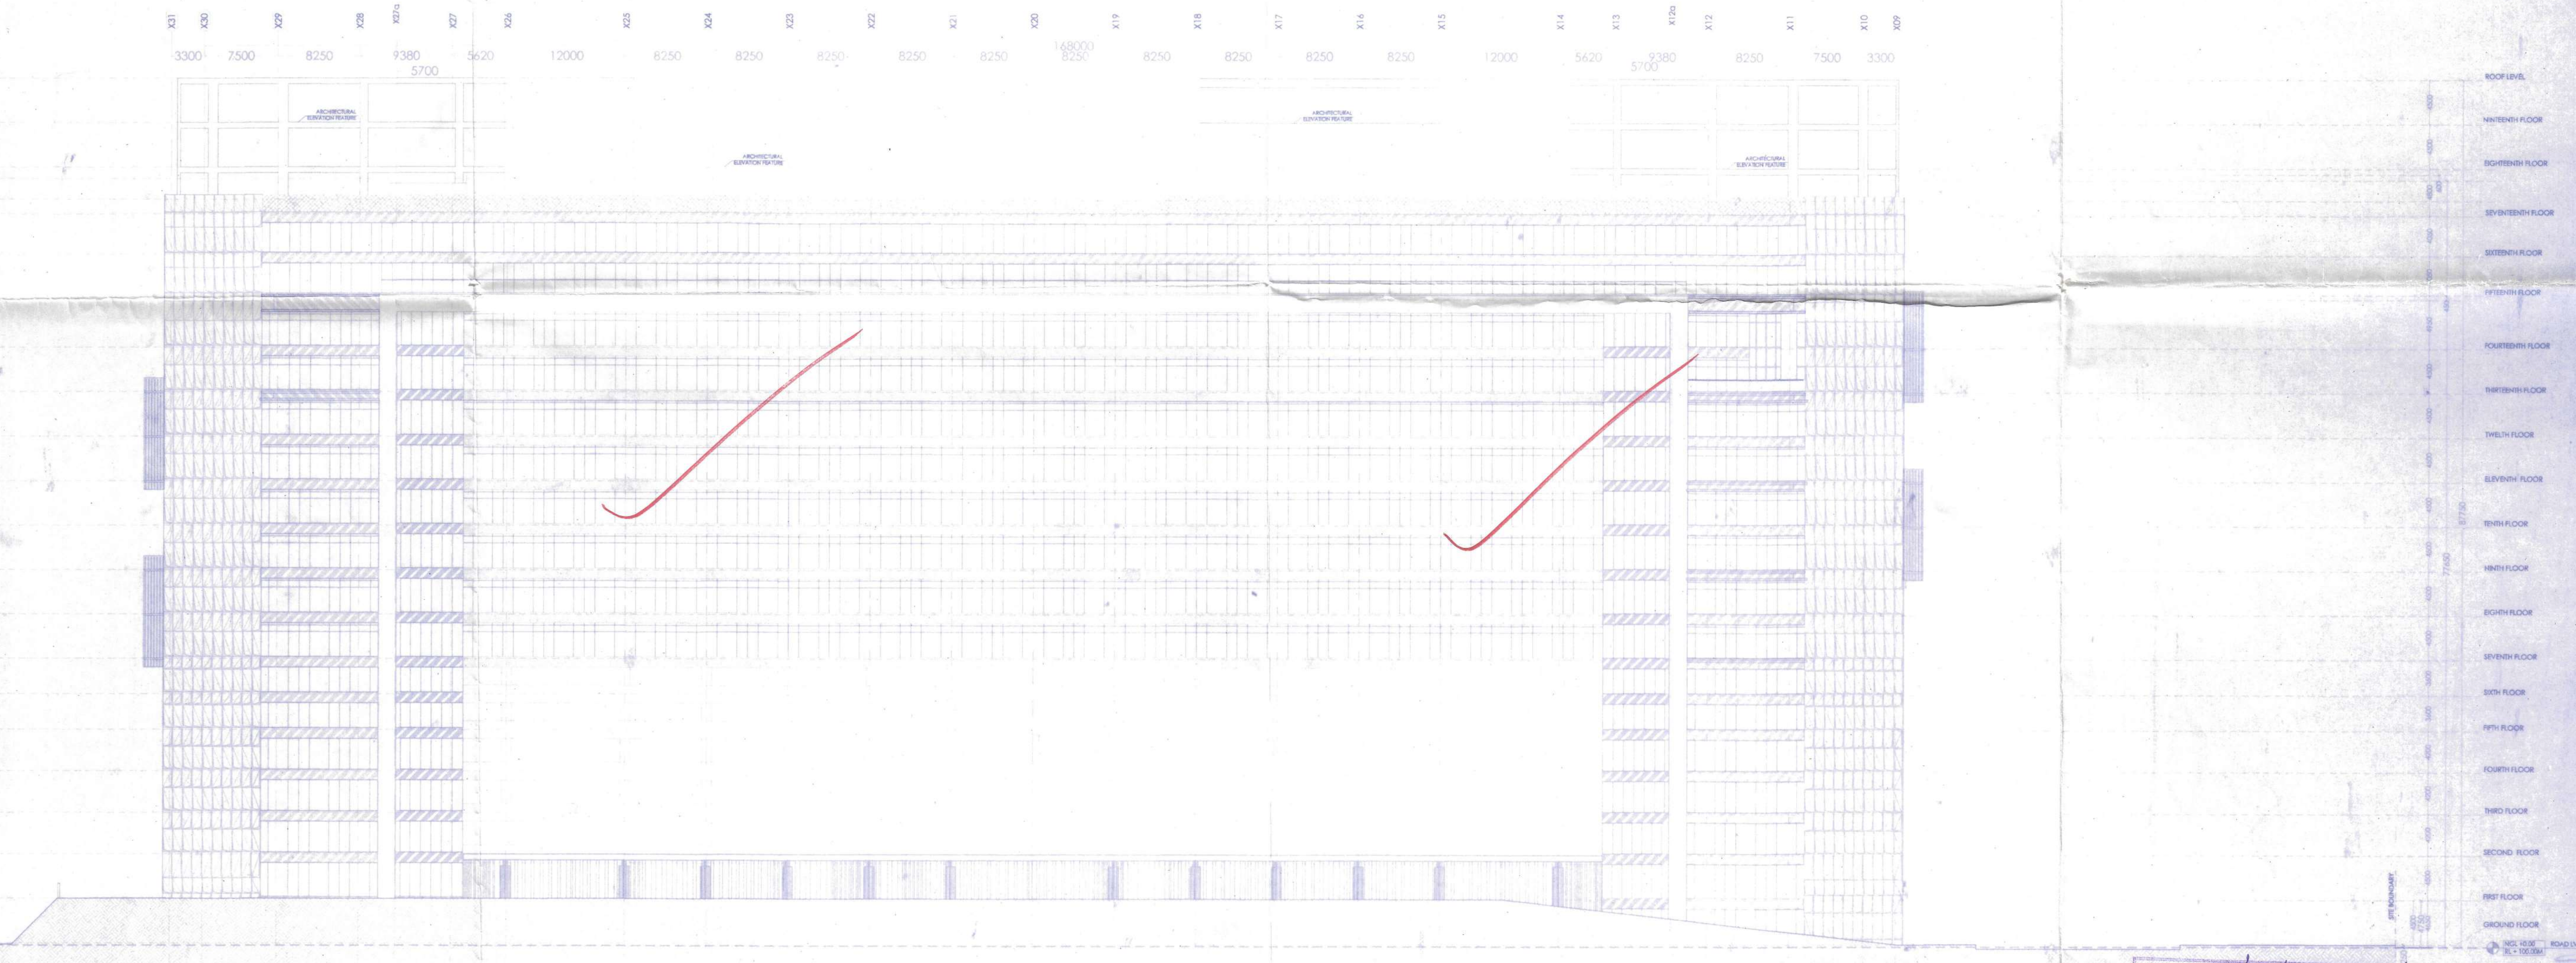

Index:- ☑- Approved Area

IADB/DO/II/SUC/13767/PGSAN/2017-18
The Karnataka Industrial Areas
DEVELOPMENT BOARD
BANGALORE - 560 001

LICENCE IS GRANTED AS PER PLAN

VALID UPTO: 08-03-2019
Date: 09/03/2018
Development Officer
& Executive Engineer - II

LOCATION PLAN

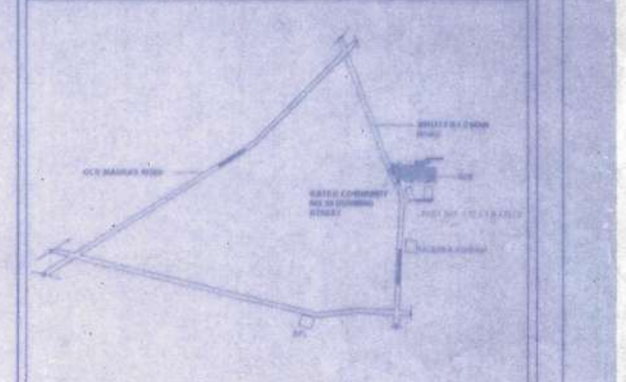

SCALE : NTS

SPECIFIC NOTES
ALL DIMENSIONS ARE IN MILLIMETRES

DETAILS OF RAIN WATER HARVESTING STRUCTURES
(R.W.H)
SECTION OF REFILLED PIT

SECTION OF
PERCOLATION PIT

MRUTHYUNJAYA
EMP No. KIADB/Engr/006/2017-18

PROJECT :
"WHITEFIELD TOWERS"
PROPOSED BUILDING (BONSAI) FOR
M/S AUBERGINE PROPERTIES PVT LTD.
ON SY NO 173/1 & 173/2 OF
KANNAMANGALA VILLAGE ,
BIDHARA HALLI HOBLI,
BANGALORE EAST TALUK,
BANGALORE -560067

OWNER'S SIGNATURE
For Aubergine Properties Pvt. Ltd.
Authorised Signatory

ARCHITECT'S SIGNATURE
Antony Kunnel George
COA Regn. No. CA/98/22820
BCC Regn. No. BCC/BL-3.2.3/A-815/98-99

SUBJECT OF THE DRAWING :
ELEVATION 01

SHEET NO :	1 OF 1
SCALE :	1:350
DATE :	18.02.2011

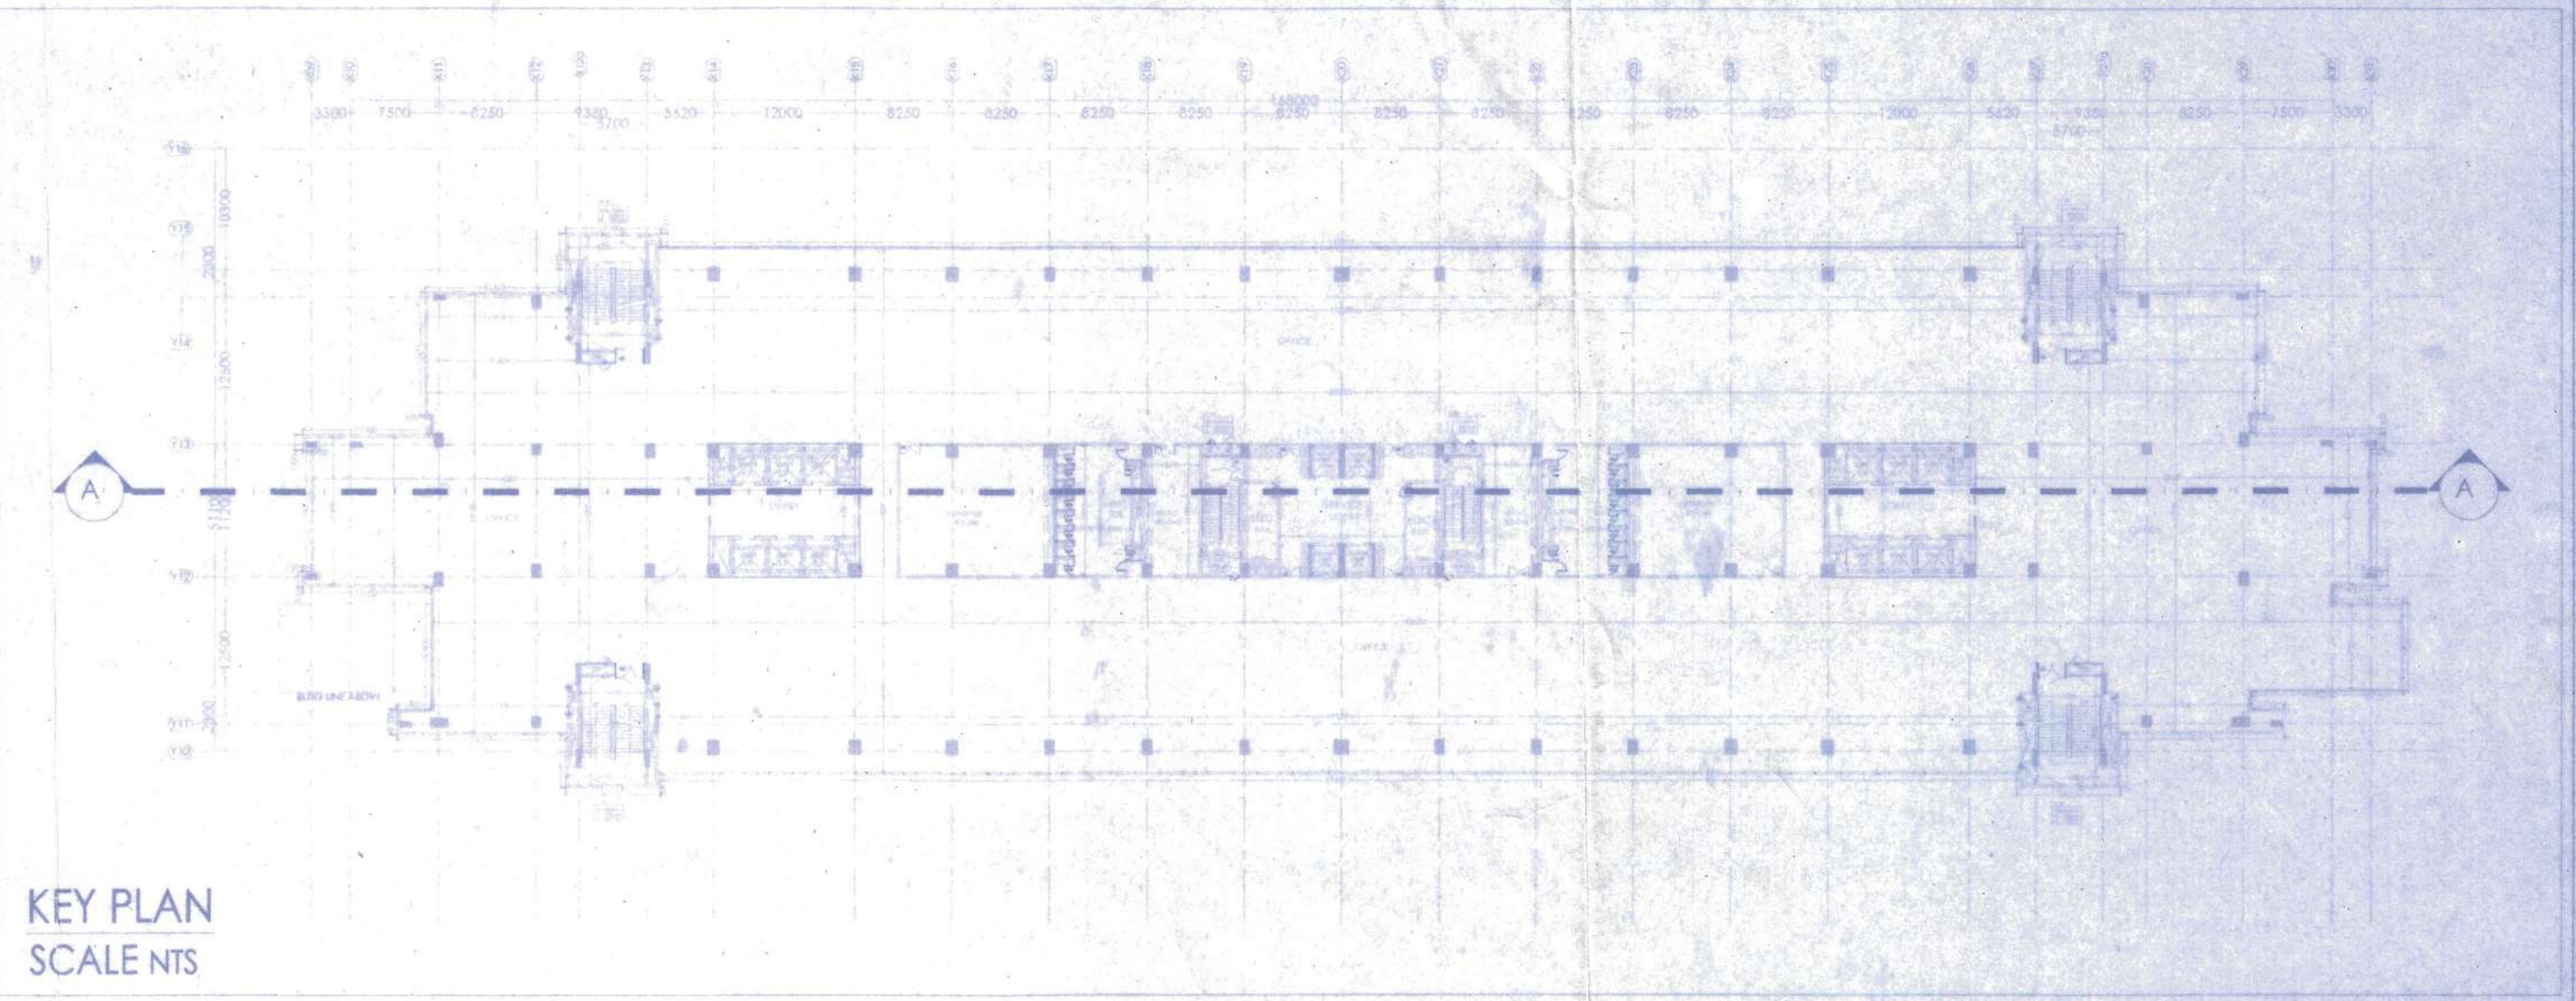

KEY PLAN
SCALE NTS

LOCATION PLAN

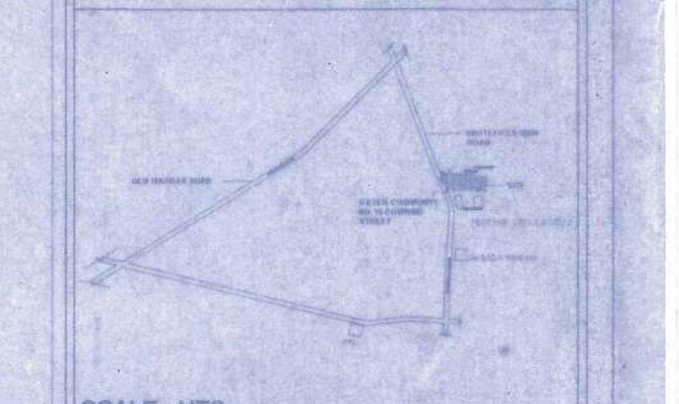

SCALE : NTS

SPECIFIC NOTES

ALL DIMENSIONS ARE IN MILLIMETRES

DETAILS OF RAIN WATER HARVESTING STRUCTURES

(R.W.H)
SECTION OF REFILLED PIT

SECTION OF
PERCOLATION PIT

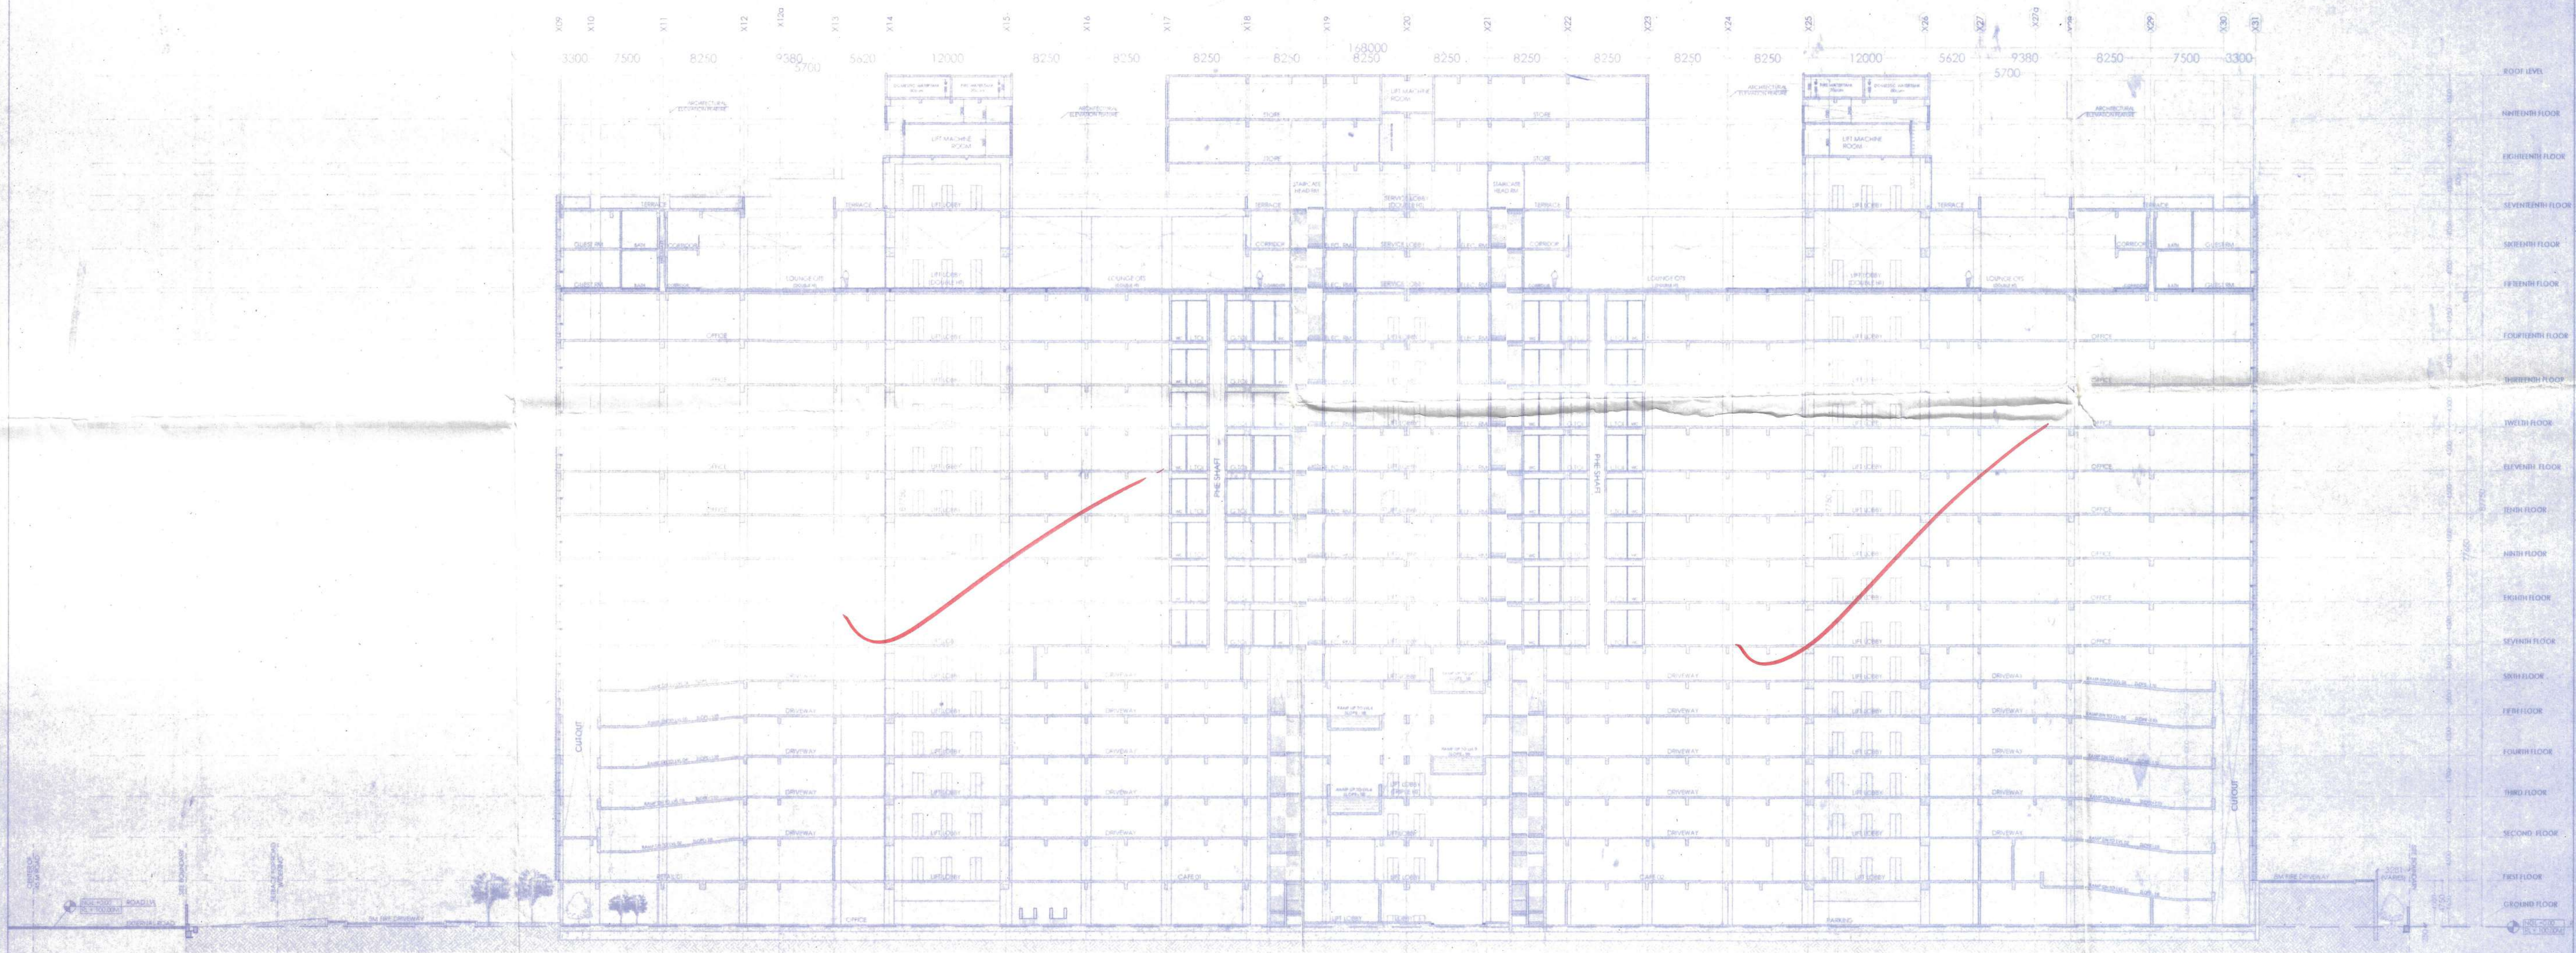

MRUTHYUNJAYA
EMP No. KIADB/Engr/006/2017-18

IADB/DO/II/SOC/13767/PGSAN/2017-18
The Karnataka Industrial Areas
DEVELOPMENT BOARD
BANGALORE - 560 001

LICENCE IS GRANTED AS PER PLAN

VALID UPTO: 08-03-2019

Date: 09/03/2018 Development Officer
& Executive Engineer - II

Index :- ☑ - Approved Area

PROJECT :

"WHITEFIELD TOWERS"
PROPOSED BUILDING (BONSAI) FOR
M/S AUBERGINE PROPERTIES PVT LTD.
ON SY NO 173/1 & 173/2 OF
KANNAMANGALA VILLAGE,
BIDHARA HALLI HOBLI,
BANGALORE EAST TALUK,
BANGALORE -560067

OWNER'S SIGNATURE

For Aubergine Properties Pvt. Ltd.

Authorised Signatory

ARCHITECT'S SIGNATURE

Antony Kunnel George
COA Regn. No. CA/98/22820
BCC Regn. No. BCC/BL-3.2.3/A-815/98-

SUBJECT OF THE DRAWING :

SECTION AA

SHEET NO :	1 OF 1
SCALE :	1:350
DATE :	18.02.2011